

KENT COUNTY REMONUMENTATION

SEP 18 1995

LAND CORNER RECORDATION CERTIFICATE

COMMISSION

Filing Requirement of Act 74, Mich. P.A. 1970

For corners in
KENT COUNTY
(County)

Located In:

Corner Code #

1. Public Land Survey	T	8N	R	12W	D-13
	T		R		
	T		R		
	T		R		
2. Property Controlling in Section	S		T	R	
	S		T	R	
3. Miscellaneous Property in Section	S		T	R	
	S		T	R	

REG. OF DEEDS

8695

95 AUG 29 AM 10:39

STATE OF MICHIGAN
COUNTY OF KENT
RECEIVED FOR RECORD

Register of Deeds Stamp & File Number

4. Lot No. _____, Recorded Plat _____
5. Private Claims _____

A	B	C	D	E	F	G	H	I	J	K	L	M
2	6	5	4	3	2	1						
3												
4	7	8	9	10	11	12						
5												
6	18	17	16	15	14	13						
7												
8	19	20	21	22	23	24						
9												
10	30	29	28	27	26	25						
11												
12	31	32	33	34	35	36						
13												

I, Kirk Breitels, in a field survey on Aug 1, 1995

do hereby certify that under requirements of P.A. 74, Michigan P.A. of 1970, the corner points mentioned in lines 1 and 2 above were in conformance with regulations and rules therefore as required in the current manual of survey instructions of the United States Department of the Interior, Bureau of Land Management or by a decree of a Court of Law and/or that the corner points mentioned in lines 3, 4 and 5 above were in conformance with the rules of the Michigan Board of Professional Surveyors or by a Decree of a Court of Law; established, re-established, monumented, re-monumented, recovered, found as expressed below:

NOTE: Not more than 4 corners, all in the same town and range, may be recorded on this certificate.

A. Description of original monument and accessories and/or subsequent restoration:

D-13	1837	GLO	Brookfield	Set Post
	1932	Kent Co. Wit.		Iron
	1981	LCRC #1419	Shangraw	Iron
	1983	LCRC #3493	Stadt	Set Kent County Monument

The position of this corner was previously approved by the Kent County Remonumentation Peer Group, monumented by Russell E. Stadt on 8/8/83 and was recorded per LCRC #3493.

B. Description of corner evidence found and/or method applied in restoring or reestablishing corner:

D-13 Found standard Kent Co. Mon. (Harrison) per witnesses from above LCRC as set by Russell E. Stadt in place of the 1/2" x 14" chisel over a 3' axle shaft in circle of broken clay tile he found. Both Chisel and axle shaft check with Kent Co. Wit. and LCRC #1419.

LCRC #3493

Nail & KC Remon. tag SE side Tel. Pole	N75°E	73.85'
Nail & KC Remon. tag W. side 6" Elm	S30°E	36.20'
Nail & KC Remon. tag NW side 12" Pine	S50°W	53.50'
C/L USGS bench mark monument	N75°W	88.23'

P.A. 345 1990 KENT COUNTY

PEER APPROVED 8/24/95

CHAIRMAN *Harry Huber*


Monument set is in centerline of 4 Mile Rd. (asph. pvt.)

The selected location is accepted by me and is generally accepted by professional surveyors as the best available evidence of the position of the original corner.

C. Description of monument for corner and accessories established to perpetuate locating the position of the corner:

D-13 Standard Kent County Monument

Nail & KC Remon. tag SE side Tel. Pole	N75°E	73.85'
New Nail & KC Remon. tag NW side 15" Pine	S50°W	53.32'
Set Nail & KC Remon. tag N. side Tel. Pole	N80°W	96.09'
C/L USGS bench mark monument	N75°W	88.23'
Kent Co. Mon. (D-1, T7N, R12W)	West	73.93'
On centerline of 4 Mile Rd. (asph. pvt.)		

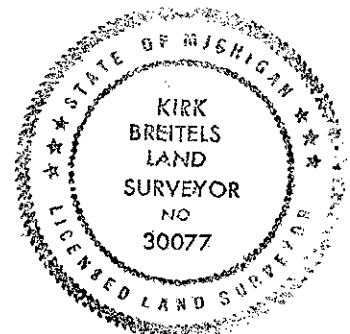

Signed by *Kirk Breitels*
Surveyor's Michigan License No. 30077

Date 8/24/95