

\$7.00
\$2.00 SEP 16 1995
COMMISSION

KENT COUNTY REMONUMENTATION

LAND CORNER RECORDATION CERTIFICATE

Filing Requirement of Act 74, Mich. P.A. 1970

For corners in
KENT COUNTY

(County)

Located In:

Corner Code #

1. Public Land Survey	T	8N	R	12W	E-8
	T		R		
	T		R		
	T		R		
2. Property Controlling in Section	S		T	R	
	S		T	R	
3. Miscellaneous Property in Sec.	S		T	R	
	S		T	R	

STATE OF MICHIGAN
COUNTY OF KENT
RECEIVED FOR RECORD
95 JUN 29 AM 11:52
REG. OF DEEDS
8449

Register of Deeds Stamp & File Number

- 4. Lot No. _____, Recorded Plat _____
- 5. Private Claims _____

A	B	C	D	E	F	G	H	I	J	K	L	M
2	6	5	4	3	2							
3												
4	7	8	9	10	11	12						
5												
6	18	17	16	15	14	13						
7												
8	19	20	21	22	23	24						
9												
10	30	29	28	27	26	25						
11												
12	31	32	33	34	35	36						
13												

I, Kirk Breitels, in a field survey on April 24, 1995, do hereby certify that under requirements of P.A. 74, Michigan P.A. of 1970, the corner points mentioned in lines 1 and 2 above were in conformance with regulations and rules therefore as required in the current manual of survey instructions of the United States Department of the Interior, Bureau of Land Management or by a decree of a Court of Law and/or that the corner points mentioned in lines 3, 4 and 5 above were in conformance with the rules of the Michigan Board of Land Surveyors or by a Decree of a Court of Law; established, re-established, monumented, re-monumented, recovered, found as expressed below:

NOTE: Not more than 4 corners, all in the same town and range, may be recorded on this certificate.

A. Description of original monument and accessories and/or subsequent restoration:

E-8	1838	GLO	Whitcomb	Set Post
	1960	Kent Co. Wit.		1 1/2" Square Iron
	1975	LCRC #817	Spicer	"T" Iron over 1 1/2" Sq. Iron
	1977	LCRC #1043	McCloskey	"T" Iron
	1981	LCRC #2617	Nederveld	Set Kent County Monument

The position of this corner was previously approved by the Kent County Remonumentation Peer Group, monumented by Gordon D. Nederveld on 9/15/81 and was recorded per LCRC #2617

B. Description of corner evidence found and/or method applied in restoring or reestablishing corner:

E-8 Found standard Kent Co. Mon. (Harrison) per witnesses from above LCRC as set by Gordon D. Nederveld in place of the "T" Iron he found. Said "T" Iron checks with Kent Co. Wit. and LCRC's #817 & #1043.

LCRC #2617

NW cor. hse. fndn.	N60°E	119.50'
SE cor. hse. fndn.	N72°W	95.00'
NE cor. hse. fndn.	S70°W	124.86'
Nail & KC Remon. tag S. side P. Pole	N86°E	53.47'
Centerline B.T. is 2' East		

P.A. 345 1990 KENT COUNTY

PEER APPROVED 6/22/95


CHAIRMAN *Harry Hubert*

The selected location is accepted by me and is generally accepted by professional surveyors as the best available evidence of the position of the original corner.

C. Description of monument for corner and accessories established to perpetuate locating the position of the corner:

E-8 Standard Kent County Monument

NW cor. hse. fndn.	N60°E	119.50'
SE cor. hse. fndn.	N72°W	95.00'
NE cor. hse. fndn.	S70°W	124.86'
Nail & KC Remon. tag S. side P. Pole	N86°E	53.47'
Nail in P. Pole	N75°W	21.97'
Centerline B.T. is 2' East		

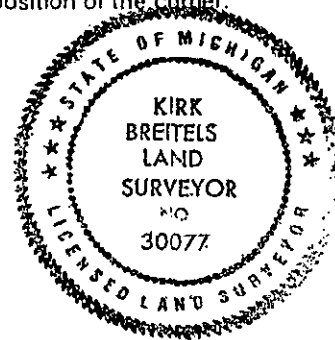

Signed by *Kirk Breitels*

Date 6/22/95

Surveyor's Michigan License No. 30077