

SURVEY &  
 REMONUMENTATION  
 \$7.00  
 \$2.00 SEP 18 1995  
 COMMISSION

KENT COUNTY REMONUMENTATION

**LAND CORNER RECORDATION CERTIFICATE**  
 Filing Requirement of Act 74, Mich. P.A. 1970

For corners in  
**KENT COUNTY**  
 (County)


Located In: Corner Code #

1. Public Land Survey	T	8N	R	12W	E-9
	T		R		
	T		R		
	T		R		
2. Property Controlling in Section	S		T	R	
	S		T	R	
3. Miscellaneous Property in Sec.	S		T	R	
	S		T	R	

STATE OF MICHIGAN  
 COUNTY OF KENT  
 RECEIVED FOR RECORD  
 95 JUN 29 AM 11:53  
 REG. OF DEEDS  
 8450

Register of Deeds Stamp & File Number

4. Lot No. \_\_\_\_\_, Recorded Plat \_\_\_\_\_  
 5. Private Claims \_\_\_\_\_

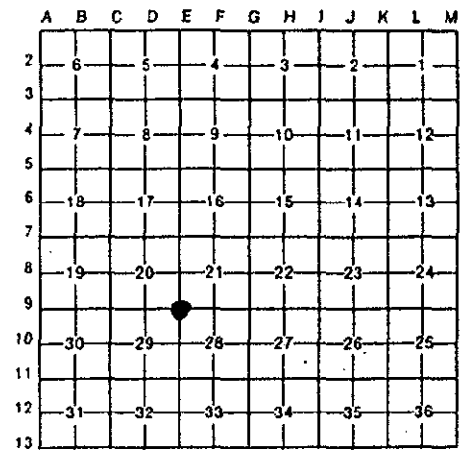

I, Kirk Breitels, in a field survey on March 1, 19 95, do hereby certify that under requirements of P.A. 74, Michigan P.A. of 1970, the corner points mentioned in lines 1 and 2 above were in conformance with regulations and rules therefore as required in the current manual of survey instructions of the United States Department of the Interior, Bureau of Land Management or by a decree of a Court of Law and/or that the corner points mentioned in lines 3, 4 and 5 above were in conformance with the rules of the Michigan Board of Land Surveyors or by a Decree of a Court of Law; established, re-established, monumented, re-monumented, recovered, found as expressed below.

**NOTE: Not more than 4 corners, all in the same town and range, may be recorded on this certificate.**

A. Description of original monument and accessories and/or subsequent restoration:

E-9	1838	GLO	Whitcomb	Set Post
	1957	Kent Co. Wit.		Conc. Mon. over stone
	1973	LCRC #612	VanKooten	RR Spike
	1981	LCRC #2611	Nederveld	Set Kent County Monument in a mon. box
	1987	LCRC #4525	Bueche	Reset Kent County Monument

P.A. 345 1990 KENT COUNTY  
 PEER APPROVED 6/22/95  
 CHAIRMAN *[Signature]*

The position of this corner was previously approved by the Kent County Remonumentation Peer Group, monumented by Gordon D. Nederveld on 10/16/81 and was recorded per LCRC #2611.

B. Description of corner evidence found and/or method applied in restoring or reestablishing corner:


E-9 Found standard Kent Co. Mon. (Harrison) per witnesses from above LCRC as set by John C. Bueche at same position as set in 1981 by Gordon D. Nederveld in place of the RR spike he found in a mon. box. Said RR spike checks with Kent Co. Wit. and LCRC #612 LCRC #4525

KC Remon. tag & nail W. side P. Pole	N20°E	123.75'	
KC Remon. tag & nail W. side P. Pole	S20°E	84.83'	(7.5' high)
SE cor. catch basin header	S15°W	21.43'	
X-cut top flared end sec., S. end conc. culv.	S05°E	71.17'	C/L St. MH East 20.47'
KC Remon. tag & nail S. side 14" Apple	N50°W	149.05'	
NW cor. back of curb at N. end 24" C & G	N20°W	64.91'	C/L blktp. rd. E-W-N
NW cor. back of curb at N. end 24" C & G	N20°E	65.43'	

The selected location is accepted by me and is generally accepted by professional surveyors as the best available evidence of the position of the original corner.

C. Description of monument for corner and accessories established to perpetuate locating the position of the corner:

E-9 Standard Kent County Monument			
KC Remon. tag & nail W. side P. Pole	N20°E	123.79'	
KC Remon. tag & nail W. side P. Pole	S20°E	84.83'	(7.5' high)
SE cor. catch basin header	S15°W	21.43'	
X-cut top flared end sec., S. end conc. culv.	S05°E	71.17'	
KC Remon. tag & nail S. side 14" Apple	N50°W	149.05'	
NW cor. back of curb at N. end 24" C & G	N20°W	64.91'	
NW cor. back of curb at N. end 24" C & G	N20°E	65.43'	
C/L Storm Manhole	East	20.47'	
Set KC Remon. tag & nail top guard rail post	N70°W	109.47'	
C/L blktp. rd. E-W-N			

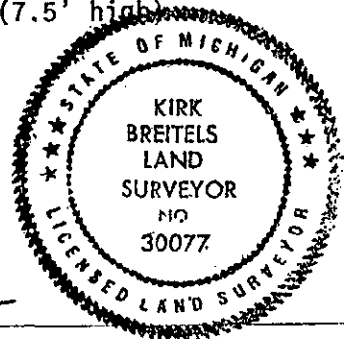

Signed by *[Signature]*  
 Surveyor's Michigan License No. 30077

Date 6/22/95