

SEP 18 1995

KENT COUNTY REMONUMENTATION

COMMISSION

LAND CORNER RECORDATION CERTIFICATE

Filing Requirement of Act 74, Mich. P.A. 1970

For corners in
KENT COUNTY
(County)

Located In:

Corner Code #

1. Public Land Survey	T	8N	R	12W	E-13
	T		R		
	T		R		
	T		R		
2. Property Controlling in Section	S		T	R	
	S		T	R	
3. Miscellaneous	S		T	R	
Property in Section	S		T	R	

REG. OF DEEDS

Lucy Bond

95 AUG 29 AM 10:39

STATE OF MICHIGAN
COUNTY OF KENT
RECEIVED FOR RECORD

8896

Register of Deeds Stamp & File Number

- 4. Lot No. _____, Recorded Plat _____
- 5. Private Claims _____

I, Kirk Breitels, in a field survey on Aug 1, 1995, do hereby certify that under requirements of P.A. 74, Michigan P.A. of 1970, the corner points mentioned in lines 1 and 2 above were in conformance with regulations and rules therefore as required in the current manual of survey instructions of the United States Department of the Interior, Bureau of Land Management or by a decree of a Court of Law and/or that the corner points mentioned in lines 3, 4 and 5 above were in conformance with the rules of the Michigan Board of Professional Surveyors or by a Decree of a Court of Law; established, re-established, monumented, re-monumented, recovered, found as expressed below:

NOTE: Not more than 4 corners, all in the same town and range, may be recorded on this certificate.

A	B	C	D	E	F	G	H	I	J	K	L	M
2	6		5		4		3		2		1	
3												
4	7		8		9		10		11		12	
5												
6	18		17		16		15		14		13	
7												
8	19		20		21		22		23		24	
9												
10	30		29		28		27		26		25	
11												
12	31		32		33		34		35		36	
13												

A. Description of original monument and accessories and/or subsequent restoration:

E-13	1837	GLO	Brookfield	Set Post
	1958	Kent Co. Wit.		Iron
	1972	LCRC #289	VanKooten	"T" Iron
	1981	LCRC #1786	Merdzinski	Set Kent County Monument

The position of this corner was previously approved by the Kent County Remonumentation Peer Group, monumented by John A. Merdzinski on 1/20/81 and was recorded per LCRC #1786

B. Description of corner evidence found and/or method applied in restoring or reestablishing corner:

E-13 Found BROKEN standard (Harrison) Kent Co. Mon. per witnesses from above LCRC as set by John A. Merdzinski in place of the "T" Iron, 6" Round Iron and Plow Point he found. All check with Kent Co. Wit. and LCRC #289. Repaired broken monument.

LCRC #1786

Nail & KC Remon. tag W. side Guy Pole	N03°W	52.48'
Nail & KC Remon. tag NW side P. Pole	N30°W	72.14'
Nail & KC Remon. tag SE side P. Pole	S50°W	97.20'
NW cor. hse. fnd. (#3194)	South	109.85'
NE cor. porch fnd. (#3194)	S15°E	104.61'
SE cor. to conc. sign (high school)	N30°E	46.56'

P.A. 345 1995 KENT COUNTY

PEER APPROVED 8/24/95

CHAIRMAN

John A. Merdzinski


C/L 4 Mile Rd. is South 2' m/l; C/L Hendershot North is West 27' m/l; Iron West 34.23' The selected location is accepted by me and is generally accepted by professional surveyors as the best available evidence of the position of the original corner.

C. Description of monument for corner and accessories established to perpetuate locating the position of the corner:

E-13 Standard Kent County Monument

Nail & KC Remon. tag W. side Guy Pole	N03°W	50.72'	(pole moved)
Nail & KC Remon. tag NW side P. Pole	N30°W	72.14'	
Nail & KC Remon. tag SE side P. Pole	S50°W	98.92'	(pole moved)
NW cor. hse. fnd. (#3194)	S00°E	109.85'	
NE cor. porch fnd. (#3194)	S15°E	104.61'	
SE cor. to conc. sign (high school)	N30°E	46.56'	
Kent Co. Mon. (E-1, T7N, R12W)	West	34.25	

C/L 4 Mile Rd. is South 2' m/l; C/L Hendershot North is West 27' m/l

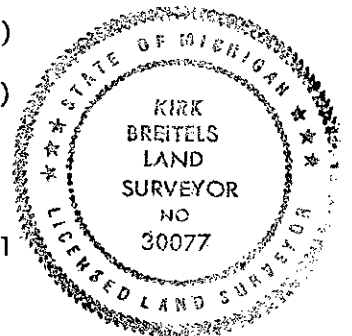

Signed by

Kirk Breitels

30077

Date

8/24/95

Surveyor's Michigan License No.