

RENEWAL PERMITS

\$7.00  
\$2.00

JAN 24 1996

KENT COUNTY REMONUMENTATION

COMMISSION LAND CORNER RECORDATION CERTIFICATE  
Filing Requirement of Act 74, Mich. P.A. 1970

For corners in KENT COUNTY (County)	Located In:	Corner Code #
1. Public Land Survey	T 8N R 12W	F-4
	T _____ R _____	_____
	T _____ R _____	_____
	T _____ R _____	_____
2. Property Controlling in Section	S _____ T _____ R _____	_____
	S _____ T _____ R _____	_____
3. Miscellaneous Property in Section	S _____ T _____ R _____	_____
	S _____ T _____ R _____	_____

STATE OF MICHIGAN  
COUNTY OF KENT  
RECEIVED FOR RECORD

95 DEC 20 AM 8:37


REG. OF DEEDS

*Lucy Bond*

8771  
Register of Deeds Stamp & File Number

4. Lot No. \_\_\_\_\_, Recorded Plat \_\_\_\_\_  
5. Private Claims \_\_\_\_\_

I, Kirk Breitels, in a field survey on Sept. 5, 1995,  
do hereby certify that under requirements of P.A. 74, Michigan P.A. of 1970, the corner points mentioned  
in lines 1 and 2 above were in conformance with regulations and rules therefore as required in the current  
manual of survey instructions of the United States Department of the Interior, Bureau of Land  
Management or by a decree of a Court of Law and/or that the corner points mentioned in lines 3, 4 and  
5 above were in conformance with the rules of the Michigan Board of Professional Surveyors or by a  
Decree of a Court of Law; established, re-established, monumented, re-monumented, recovered, found  
as expressed below:

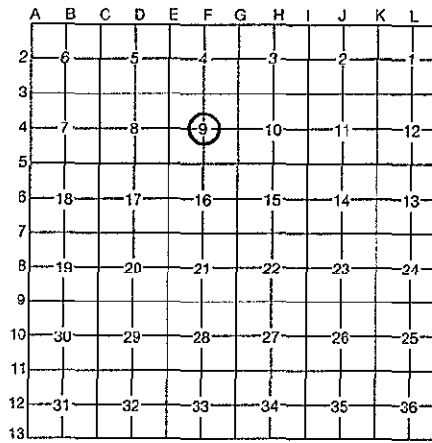

NOTE: Not more than 4 corners, all in the same town and range, may be recorded on this certificate.

A. Description of original monument and accessories and/or subsequent restoration:

F-4 1837 GLO Not Set  
1992 Survey Roosien Capped "T" Iron  
No other information for this corner

P.A. 345 1990 KENT COUNTY  
PEER APPROVED 9/28/95  
CHAIRMAN *Harry Huber*


B. Description of corner evidence found and/or method applied in restoring or reestablishing corner:

F-4 Found Capped (Consumers Power Co.) "T" Iron on East line of CP Co. transmission tower line, 2.8' S. & 0.5' W. of intersection of 1/4 lines. Also found CP Co. Capped "T" Iron and Roosien Capped rerod 66' West of the Capped "T" Iron at the Center. Consumers Power Co. did not have any information available for this corner. Measurements and angles in Northwest 1/4 agree with those of the 1992 Roosien survey:

The Capped (CP Co.) "T" Iron is accepted by me and is generally accepted by professional surveyors as the best available evidence of the position of the corner.

C. Description of monument for corner and accessories established to perpetuate locating the position of the corner:

F-4 Set Standard Kent County Monument in place of Capped (CP Co.) "T" Iron.  
Set Nail & KC Remon. tag S. side 24" Hickory S75°E 484.90'  
C/L W. bolt for diagonal brace  
@ NW cor. CP Co. Tower (@ ground level) S05°W 223.02'  
Set Nail & KC Remon. tag NE side 18" Apple N40°W 50.98'  
Set Nail & KC Remon. tag W. side 16" Elm N10°E 102.20'  
Capped Rerod (Roosien) West 66.00'

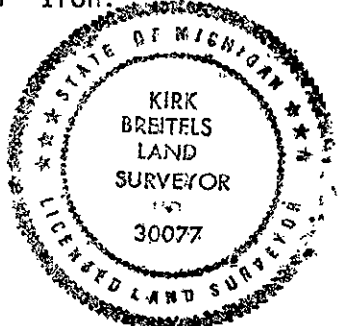

Signed by *Kirk Breitels* Date 12/6/95  
Surveyor's Michigan License No. 30077