

\$7.00
\$2.00

SEP 13 1995

COMMISSION

KENT COUNTY REMONUMENTATION

LAND CORNER RECORDATION CERTIFICATE

Filing Requirement of Act 74, Mich. P.A. 1970

For corners in
KENT COUNTY

(County)	Located In:	Corner Code #
1. Public Land Survey	T 8N R 12W	F-7
	T R	
	T R	
	T R	
2. Property Controlling in Section	S T R	
	S T R	
3. Miscellaneous Property in Sec.	S T R	
	S T R	
4. Lot No. _____, Recorded Plat _____		
5. Private Claims _____		

STATE OF MICHIGAN
COUNTY OF KENT
RECEIVED FOR RECORD

95 JUN 29 AM 11:53

REG. OF DEEDS

Register of Deeds Stamp & File Number

I, Kirk Breitels, in a field survey on Feb. 15, 19 95, do hereby certify that under requirements of P.A. 74, Michigan P.A. of 1970, the corner points mentioned in lines 1 and 2 above were in conformance with regulations and rules therefore as required in the current manual of survey instructions of the United States Department of the Interior, Bureau of Land Management or by a decree of a Court of Law and/or that the corner points mentioned in lines 3, 4 and 5 above were in conformance with the rules of the Michigan Board of Land Surveyors or by a Decree of a Court of Law; established, re-established, monumented, re-monumented, recovered, found as expressed below:

NOTE: Not more than 4 corners, all in the same town and range, may be recorded on this certificate.

A. Description of original monument and accessories and/or subsequent restoration:

F-7	1838	GLO	Whitcomb	Set Post
	1935	Kent Co. Wit.		Conc. Mon.
	1980	LCRC #1350	Bonnema	Mon. Box
	1981	LCRC #2409	Bueche	Set Kent County Monument in mon. box

The position of this corner was previously approved by the Kent County Remonumentation Peer Group, monumented by John C. Bueche on 11/11/81 and was recorded per LCRC #2409.

B. Description of corner evidence found and/or method applied in restoring or reestablishing corner:

F-7 Found standard Kent Co. Mon. (Harrison) per witnesses from above LCRC as set by John C. Bueche in place of the 1" x 18" over a 1" x 18" Iron he found inside a mon. box. Both Irons check with Kent Co. Wit. and LCRC #1350.

LCRC #2409

KC Remon. tag & nail E. side P. Pole	N05°W	202.20'
KC Remon. tag & nail S. side 14" Pine	N72°W	271.30'
"X" cut on W. end conc. culv.	S80°E	164.87'
"X" cut on E. end conc. culv.	S80°W	110.60'
on C/L blktp. E-W		
C/L of Power line N-S is West 15' m/l		


P.A. 345 1990 KENT COUNTY

PEER APPROVED 6/22/95
CHAIRMAN Harvey Huber

The selected location is accepted by me and is generally accepted by professional surveyors as the best available evidence of the position of the original corner.

C. Description of monument for corner and accessories established to perpetuate locating the position of the corner:

F-7 Standard Kent County Monument in mon. box		
KC Remon. tag & nail E. side P. Pole	N05°W	202.20'
PK Nail in side of Tel. Pole	N00°W	140.17'
"X" cut W. end conc. culv.	N80°E	164.90'
"X" cut on E. end conc. culv.	S80°W	110.60'
on C/L blktp. E-W		
C/L of Power line N-S is West 15' m/l		

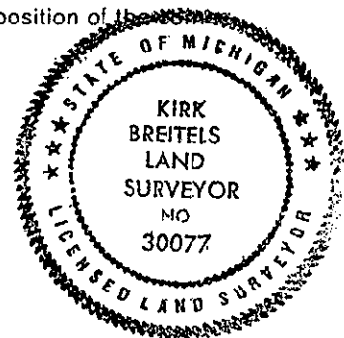

Signed by Kirk Breitels

Date 6/22/95

Surveyor's Michigan License No. 30077