

\$7.00
\$2.00 SEP 18 1995

KENT COUNTY REMONUMENTATION

COMMISSION

LAND CORNER RECORDATION CERTIFICATE
Filing Requirement of Act 74, Mich. P.A. 1970

For corners in
KENT COUNTY

(County)

Located In:

Corner Code #

1. Public Land Survey	T	8N	R	12W	F-9
	T		R		
	T		R		
	T		R		
2. Property Controlling in Section	S		T	R	
	S		T	R	
3. Miscellaneous Property in Sec.	S		T	R	
	S		T	R	

STATE OF MICHIGAN
COUNTY OF KENT
RECEIVED FOR RECORD
95 JUN 29 AM 11:53
REG. OF DEEDS
8458

Register of Deeds Stamp & File Number

4. Lot No. _____, Recorded Plat _____
5. Private Claims _____

	A	B	C	D	E	F	G	H	I	J	K	L	M
2	6		5		4		3		2		1		
3													
4	7		8		9		10		11		12		
5													
6	18		17		16		15		14		13		
7													
8	19		20		21		22		23		24		
9													
10	30		29		28		27		26		25		
11													
12	31		32		33		34		35		36		
13													

I, Kirk Breitels, in a field survey on March 1, 19 95, do hereby certify that under requirements of P.A. 74, Michigan P.A. of 1970, the corner points mentioned in lines 1 and 2 above were in conformance with regulations and rules therefore as required in the current manual of survey instructions of the United States Department of the Interior, Bureau of Land Management or by a decree of a Court of Law and/or that the corner points mentioned in lines 3, 4 and 5 above were in conformance with the rules of the Michigan Board of Land Surveyors or by a Decree of a Court of Law; established, re-established, monumented, re-monumented, recovered, found as expressed below:

NOTE: Not more than 4 corners, all in the same town and range, may be recorded on this certificate.

A. Description of original monument and accessories and/or subsequent restoration:

F-9	1838	GLO	Whitcomb	Set Post
	1935	Kent Co. Wit.		Iron & Stones
	1977	LCRC #1043	McCloskey	3/4" Pipe
	1977	LCRC #1084	VanKooten	3/4" Iron
	1981	LCRC #2410	Bueche	Set Kent County Monument
	1991	LCRC #5731	Bueche	Reset Kent County Monument

The position of this corner was previously approved by the Kent County Remonumentation Peer Group, monumented by John C. Bueche on 11/12/81 and was recorded per LCRC #2410.

B. Description of corner evidence found and/or method applied in restoring or reestablishing corner:

F-9 Found standard Kent Co. Mon. (Harrison) per witnesses from above LCRC as set by John C. Bueche in place of the 3/4" Iron over a 1" Iron he found over a 1 1/4" Iron in stones. All Irons & stones check with Kent Co. Wit. and LCRC's #1043 & #1084.

LCRC #5731 (same as remaining witnesses from LCRC #2410)

Nail & Remon. tag E. side P. Pole (6' high)	S45°W	109.40'
Nail & Remon. tag NW side Tel. P. Pole	N50°E	31.73'
SW cor. conc. dr.	N05°E	30.42'
SW leg of tower	N15°W	69.21'
Nail & Remon. tag S. side 6" tree	N80°E	75.23'

C/L P. line N-S is West 16' m/l
C/L blacktop E-W is South 14' m/l

The selected location is accepted by me and is generally accepted by professional surveyors as the best available evidence of the position of the original corner.


P.A. 345 1990 KENT COUNTY

PEER APPROVED 6/22/95

CHAIRMAN *[Signature]*

C. Description of monument for corner and accessories established to perpetuate locating the position of the corner:

F-9 Standard Kent County Monument		
Nail & Remon. tag E. side P. Pole (6' high)	S45°W	109.50'
Nail & Remon. tag NW side Tel. P. Pole	N50°E	31.64'
SW cor. conc. dr.	N05°E	30.42'
SW leg of tower	N15°W	69.05'
C/L P. line N-S is West 16' m/l		
C/L blacktop E-W is South 14' m/l		

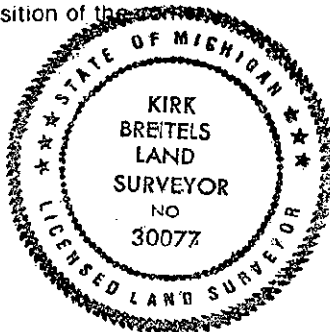

Signed by Kirk Breitels Date 6/22/95
Surveyor's Michigan License No. 30077