

KENT COUNTY & GENTRION

KENT COUNTY REMONUMENTATION

\$7.00  
\$2.00

JAN 24 1996

COMMISSION LAND CORNER RECORDATION CERTIFICATE  
Filing Requirement of Act 74, Mich. P.A. 1970

For corners in  
KENT COUNTY  
(County)

Located In:

Corner Code #

1. Public Land Survey	T	8N	R	12W	F-10
	T		R		
	T		R		
	T		R		
2. Property Controlling in Section	S		T	R	
	S		T	R	
3. Miscellaneous Property in Section	S		T	R	
	S		T	R	

REG. OF DEEDS

*[Signature]*

95 DEC 20 AM 8:38

STATE OF MICHIGAN  
COUNTY OF KENT  
RECEIVED FOR RECORD

8789

Register of Deeds Stamp & File Number

- 4. Lot No. \_\_\_\_\_, Recorded Plat \_\_\_\_\_
- 5. Private Claims \_\_\_\_\_

A	B	C	D	E	F	G	H	I	J	K	L	M
2	6	5	4	3	2	1						
3												
4	7	8	9	10	11	12						
5												
6	13	17	16	15	14	13						
7												
8	19	20	21	22	23	24						
9												
10	30	29	28	27	26	25						
11												
12	31	32	33	34	35	36						
13												

I, Kirk Breitels, in a field survey on Sept. 7, 1995

do hereby certify that under requirements of P.A. 74, Michigan P.A. of 1970, the corner points mentioned in lines 1 and 2 above were in conformance with regulations and rules therefore as required in the current manual of survey instructions of the United States Department of the Interior, Bureau of Land Management or by a decree of a Court of Law and/or that the corner points mentioned in lines 3, 4 and 5 above were in conformance with the rules of the Michigan Board of Professional Surveyors or by a Decree of a Court of Law; established, re-established, monumented, re-monumented, recovered, found as expressed below:

NOTE: Not more than 4 corners, all in the same town and range, may be recorded on this certificate.

A. Description of original monument and accessories and/or subsequent restoration:

- F-10 1837 GLO Not Set  
Kent Co. Wit. Iron at N. side fence post
- 1938-70 Williams & Works Iron at N. side fence post  
True Center is 0.6' W. & 9.2' S.
- 1981 LCRC #1609 Bonnema 3/4" Iron 0.39' E. & 8.99' N. of "X" 1/4 lines  
24" Cherry W 83.55'; 8" Cherry SE 4.57'; 6" Cherry S 16.20'
- 1984 Survey Williams & Works 3/4" Iron at cor. fence post

B. Description of corner evidence found and/or method applied in restoring or reestablishing corner:

F-10 Found 3/4" Iron Pipe at N. side of corner fence post per remaining witnesses of those above. Said Iron Pipe is 8.9' N. & 0.2' E. of intersection of 1/4 lines. Fences run S. & W. from said 3/4" Iron Pipe.

The 3/4" Iron Pipe is accepted by me and is generally accepted by professional surveyors as the best available evidence of the position of the corner.


P.A. 345 1990 KENT COUNTY

PEER APPROVED 9/28/95

CHAIRMAN *[Signature]*

C. Description of monument for corner and accessories established to perpetuate locating the position of the corner:

- F-10 Set Standard Kent County Monument in place of the 3/4" Iron Pipe
- Set Nail & KC Remon. tag N. side 12" Cherry S80°E 3.85'
- Set Nail & KC Remon. tag E. side 8" Cherry S40°E 10.97'
- Set Nail & KC Remon. tag E. side 12" Cherry S05°E 16.06'
- Set Nail & KC Remon. tag S. side 8" Cherry S90°W 34.32'

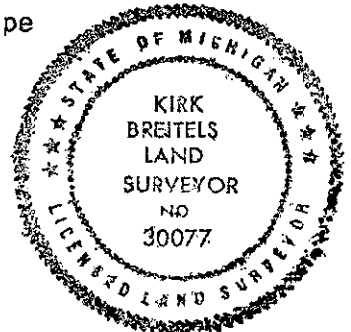

Signed by *[Signature]*

Date 12/6/95

Surveyor's Michigan License No. 30077