

\$7.00 SEP 18 1995
\$2.00 COMMISSION

KENT COUNTY REMONUMENTATION

LAND CORNER RECORDATION CERTIFICATE
Filing Requirement of Act 74, Mich. P.A. 1970


For corners in
KENT COUNTY

(County)	Located In:	Corner Code #
1. Public Land Survey	T 8N R 12W	G-3
	T _____ R _____	_____
	T _____ R _____	_____
	T _____ R _____	_____
2. Property Controlling in Section	S _____ T _____ R _____	_____
	S _____ T _____ R _____	_____
3. Miscellaneous Property in Sec.	S _____ T _____ R _____	_____
	S _____ T _____ R _____	_____

STATE OF MICHIGAN
COUNTY OF KENT
RECEIVED FOR RECORD
95 JUN 29 AM 11:54
REG. OF DEEDS
8463

Register of Deeds Stamp & File Number

4. Lot No. _____, Recorded Plat _____
5. Private Claims _____

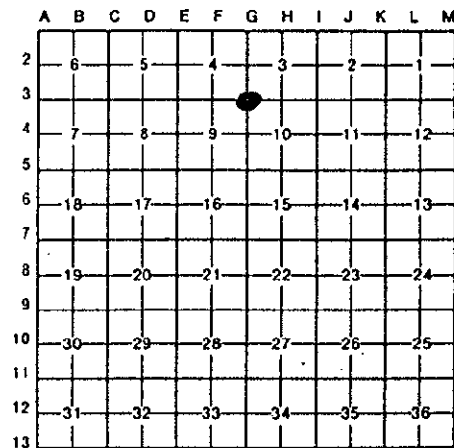

I, Kirk Breitels, in a field survey on Feb. 15, 19 95, do hereby certify that under requirements of P.A. 74, Michigan P.A. of 1970, the corner points mentioned in lines 1 and 2 above were in conformance with regulations and rules therefore as required in the current manual of survey instructions of the United States Department of the Interior, Bureau of Land Management or by a decree of a Court of Law and/or that the corner points mentioned in lines 3, 4 and 5 above were in conformance with the rules of the Michigan Board of Land Surveyors or by a Decree of a Court of Law; established, re-established, monumented, re-monumented, recovered, found as expressed below:

NOTE: Not more than 4 corners, all in the same town and range, may be recorded on this certificate.

A. Description of original monument and accessories and/or subsequent restoration:

G-3	1838 GLO	Whitcomb	Set Post
	1888-1969 Williams & Works		Leaded Stone
	Kent Co. Wit.		Leaded Stone
1985	LCRC #4332	Bueche	Set Kent County Monument

The position of this corner was previously approved by the Kent County Remonumentation Peer Group, monumented by John C. Bueche on 10/17/85 and was recorded per LCRC #4332.

B. Description of corner evidence found and/or method applied in restoring or reestablishing corner:

G-3 Found standard Kent Co. Mon. (Harrison) per witnesses from above LCRC as set by John C. Bueche in place of the Capped Iron (Hay) he found next to a stone. Said Capped Iron checks with Kent Co. Wit. and Williams & Works information

LCRC #4332

PK Nail NE side Service Pole	N60°W	165.71'
PK Nail N. side Power Pole	S65°W	124.87'
SE cor. brick house	N15°W	150.69'
Iron in conc.	North	33.15'
KC Remon. tag & nail top of fence post on C/L blacktop E-W, now of fence line South	South	22.00'

P.A. 345 1990 KENT COUNTY
PEER APPROVED 6/22/95
CHAIRMAN Harry Bueche

The selected location is accepted by me and is generally accepted by professional surveyors as the best available evidence of the position of the original corner.

C. Description of monument for corner and accessories established to perpetuate locating the position of the corner:

G-3 Standard Kent County Monument		
PK Nail NE side Service Pole	N60°W	165.71'
PK Nail N. side Power Pole	S65°W	124.87'
SE cor. brick house	N15°W	150.69'
Iron in conc.	North	33.15'
KC Remon. tag & nail top of fence post on C/L blacktop E-W, now of fence line South	South	22.48'



Signed by Kirk Breitels
Surveyor's Michigan License No. 30077

Date 6/22/95