

\$7.00 SEP 13 1995 \$2.00 COMMISSION

KENT COUNTY REMONUMENTATION


LAND CORNER RECORDATION CERTIFICATE Filing Requirement of Act 74, Mich. P.A. 1970

For corners in KENT COUNTY Located in: Corner Code # 1. Public Land Survey T 8N R 12W G-7

STATE OF MICHIGAN COUNTY OF KENT RECEIVED FOR RECORD 95 JUN 29 AM 11:54 REG. OF DEEDS 8467 Register of Deeds Stamp & File Number

4. Lot No. Recorded Plat 5. Private Claims

I, Kirk Breitels, in a field survey on Feb. 15, 1995, do hereby certify that under requirements of P.A. 74, Michigan P.A. of 1970, the corner points mentioned in lines 1 and 2 above were in conformance with regulations and rules therefore as required in the current manual of survey instructions of the United States Department of the Interior, Bureau of Land Management or by a decree of a Court of Law and/or that the corner points mentioned in lines 3, 4 and 5 above were in conformance with the rules of the Michigan Board of Professional Surveyors or by a Decree of a Court of Law, established, re-established, monumented, re-monumented, recovered, found as expressed below:

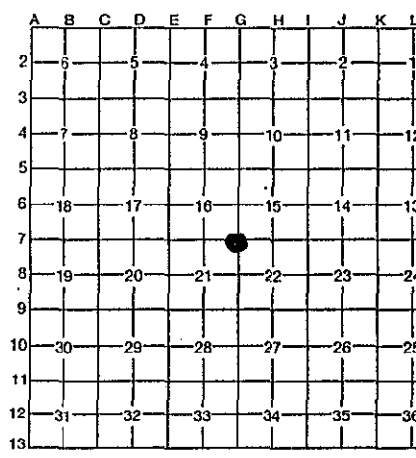

NOTE: Not more than 4 corners, all in the same town and range, may be recorded on this certificate.

A. Description of original monument and accessories and/or subsequent restoration:

Table with 5 columns: Corner Code, Year, Description, Name, and Material. Row 1: G-7, 1838, GLO, Whitcomb, Set Post. Row 2: 1980, LCRC #1350, Kent Co. Wit., Bonnema, Iron. Row 3: 1981, LCRC #2412, Bueche, 1/2" Iron in mon. box. Row 4: Set Kent County Monument in mon. box.

The position of this corner was previously approved by the Kent County Remonumentation Peer Group, monumented by John C. Bueche on 11/11/81 and was recorded per LCRC #2412.

B. Description of corner evidence found and/or method applied in restoring or reestablishing corner:

G-7 Found standard Kent Co. Mon. (Harrison) per witnesses from above LCRC as set by John C. Bueche in place of the 1/2" x 18" Iron he found over a 1/2" Iron inside a mon. box. Both Irons check with Kent Co. Wit. and LCRC #1350.

LCRC #2412

Table with 4 columns: Evidence Description, Bearing, Distance, and Notes. Row 1: KC Remon. tag & nail NE side 34" Pine, S60°E, 83.40', P.A. 345 1990 KENT COUNTY. Row 2: KC Remon. tag & nail N. side 10" Apple, N50°W, 105.39', PEER APPROVED 6/22/95. Row 3: KC Remon. tag & nail in top of guard rail post, N70°E, 78.80', CHAIRMAN Harry Stube. Row 4: NE corner foundation to bldg., S35°W, 63.73'. Row 5: "X" cut in conc. curb return, N25°W, 51.98'. Row 6: "X" cut in conc. curb, S00°E, 24.12'.

The selected location is accepted by me and is generally accepted by professional surveyors as the best available evidence of the position of the original corner.

C. Description of monument for corner and accessories established to perpetuate locating the position of the corner:

G-7 Standard Kent County Monument

Table with 4 columns: Monument Description, Bearing, Distance, and Notes. Row 1: New KC Remon. tag & nail NE side 40" Pine, S60°E, 83.47'. Row 2: KC Remon. tag & nail in top of guard rail post, N70°E, 78.76'. Row 3: NE corner foundation to bldg., S35°W, 63.68'. Row 4: "X" cut in conc. curb return, N25°W, 51.98'. Row 5: "X" cut in conc. curb, S00°E, 24.12'. Row 6: on C/L blktp. E & W, on C/L blktp. N.



Signed by [Signature] Date 6/22/95 Surveyor's Michigan License No. 30077