

SEP 18 1995

KENT COUNTY REMONUMENTATION

COMMISSION

LAND CORNER RECORDATION CERTIFICATE

Filing Requirement of Act 74, Mich. P.A. 1970

For corners in KENT COUNTY (County)

Located in:

Corner Code #

1. Public Land Survey	T	8N	R	12W	G-13
	T		R		
	T		R		
	T		R		
2. Property Controlling in Section	S		T	R	
	S		T	R	
3. Miscellaneous Property in Section	S		T	R	
	S		T	R	

STATE OF MICHIGAN  
 COUNTY OF KENT  
 RECEIVED FOR RECORD  
 959 AUG 29 AM 10:39  
 REGISTER OF DEEDS  
 8697

Register of Deeds Stamp & File Number

4. Lot No. \_\_\_\_\_, Recorded Plat \_\_\_\_\_  
 5. Private Claims \_\_\_\_\_

A	B	C	D	E	F	G	H	I	J	K	L	M
2	6	5	4	3	2	1						
3												
4	7	8	9	10	11	12						
5												
6	18	17	16	15	14	13						
7												
8	19	20	21	22	23	24						
9												
10	30	29	28	27	26	25						
11												
12	31	32	33	34	35	36						
13												

I, Kirk Breitels, in a field survey on July 5, 1995, do hereby certify that under requirements of P.A. 74, Michigan P.A. of 1970, the corner points mentioned in lines 1 and 2 above were in conformance with regulations and rules therefore as required in the current manual of survey instructions of the United States Department of the Interior, Bureau of Land Management or by a decree of a Court of Law and/or that the corner points mentioned in lines 3, 4 and 5 above were in conformance with the rules of the Michigan Board of Professional Surveyors or by a Decree of a Court of Law; established, re-established, monumented, re-monumented, recovered, found as expressed below:

NOTE: Not more than 4 corners, all in the same town and range, may be recorded on this certificate.

A. Description of original monument and accessories and/or subsequent restoration:

G-13	1837	GLO	Brookfield	Set Post
	1962	Kent Co. Wit.		1 1/2" Iron in mon. box
	1972	LCRC #226	Spicer	Set PK Nail from previous wits.
	1982	LCRC #3155	Hackbardt	Set Kent County Monument

The position of this corner was previously approved by the Kent County Remonumentation Peer Group, monumented by Glen S. Hackbardt on 8/5/82 and was recorded per LCRC #3155

B. Description of corner evidence found and/or method applied in restoring or reestablishing corner:

G-13 Found standard Kent Co. Mon. (Harrison) per witnesses from above LCRC as set by Glen S. Hackbardt in place of the PK Nail he found. Said PK Nail checks with LCRC #226. Kent Co. Wit. were for an incorrect corner 2.64' East of this corner.

LCRC #3155

Nail & KC Remon. tag 20" Maple	N60°W	89.90'
NE corner of House foundation	S30°W	113.52'
Nail & KC Remon. tag 8" Pine	N40°W	87.12'
Nail & KC Remon. tag 26" Ash	N25°E	34.20'
Nail & KC Remon. tag 12" Elm	N55°E	65.95'


P.A. 345 1990 KENT COUNTY  
 PEER APPROVED 8/24/95  
 CHAIRMAN [Signature]

The selected location is accepted by me and is generally accepted by professional surveyors as the best available evidence of the position of the original corner.

C. Description of monument for corner and accessories established to perpetuate locating the position of the corner:

G-13 Standard Kent County Monument

New Nail & KC Remon. tag NE side 20" Maple	N60°W	98.85'
NE corner of House foundation	S30°W	113.57'
New Nail & KC Remon. tag SW side 12" Pine	N40°W	87.12'
New Nail & KC Remon. tag W. side 36" Ash	N25°E	34.24'
Set Nail & KC Remon. tag W. side Tw. 12" Maple	N25°W	37.45'
Kent Co. Mon. (G-1, T7N, R12W)	East	1.32'

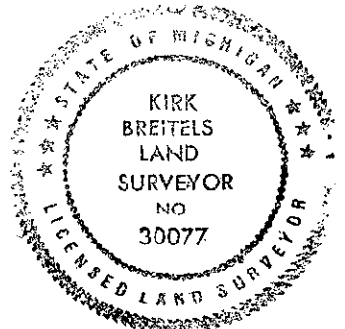

Signed by [Signature]  
 Surveyor's Michigan License No. 30077

Date 8/24/95