$7.00
$2.00

SEP 1 8 1995

KENT COUNTY REMONUMENTATION

LAND CORNER RECORDATION CERTIFICATE

Filing Requirement of Act 74, Mich. P.A. 1970

STATE OF MICHIGAN
COUNTY OF KENT
RECEIVED FOR RECORD
95 JUN 29 AM 11:55
REG. OF DEEDS
8473

Register of Deeds Stamp & File Number

For corners in KENT COUNTY (County)

	Located In:	Corner Code #
1. Public Land Survey	T 8N R 12W	H-1
	T ___ R ___	
	T ___ R ___	
	T ___ R ___	
2. Property Controlling	S ___ T ___ R ___	
in Section	S ___ T ___ R ___	
3. Miscellaneous	S ___ T ___ R ___	
Property in Section	S ___ T ___ R ___	

4. Lot No. _____, Recorded Plat _____
5. Private Claims _____

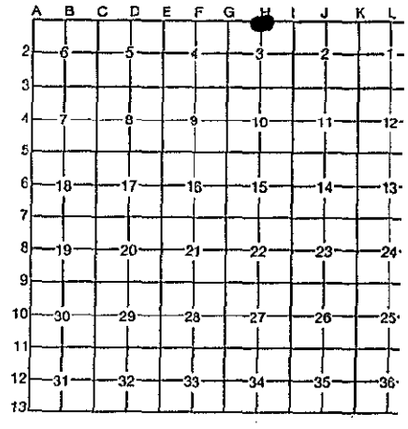

I, Kirk Breitels, in a field survey on Jan. 25, 19 95, do hereby certify that under requirements of P.A. 74, Michigan P.A. of 1970, the corner points mentioned in lines 1 and 2 above were in conformance with regulations and rules therefore as required in the current manual of survey instructions of the United States Department of the Interior, Bureau of Land Management or by a decree of a Court of Law and/or that the corner points mentioned in lines 3, 4 and 5 above were in conformance with the rules of the Michigan Board of Professional Surveyors or by a Decree of a Court of Law; established, re-established, monumented, re-monumented, recovered, found as expressed below:

NOTE: Not more than 4 corners, all in the same town and range, may be recorded on this certificate.

A. Description of original monument and accessories and/or subsequent restoration:

H-1	1838	GLO	Whitcomb	Not Set
	1952	Kent Co. Wit.		Mon. Box
	1959	Williams & Works		Mon. Box
	1984	LCRC #4088	Kolehouse	Set Kent County Monument

The position of this corner was previously approved by the Kent County Remonumentation Peer Group, monumented by Randy J. Kolehouse on 12/15/84 and was recorded per LCRC #4088

B. Description of corner evidence found and/or method applied in restoring or reestablishing corner:
H-1 Found standard Kent Co. Mon. (Harrison) per witnesses from above LCRC as set by Randy J. Kolehouse on the township line in place of the 3/4" Iron in mon. box he found. Said Iron in mon. box checks with Kent Co. Wit. and Willams & Works information.
LCRC #4088

Nail & KC Remon. tag S. side P. Pole	N50°W	55.45'
Chiseled "X" W. end 15" conc. culv.	S40°W	51.3'
Chiseled "X" E. end 15" conc. culv.	S45°E	58.9'
KC Mon. at S 1/4 cor. Sec. 34, T9N, R12W	West	76.7'

P.A. 3.5 1996 KENT COUNTY
PEER APPROVED 6/22/95
CHAIRMAN Larry Hubert

The selected location is accepted by me and is generally accepted by professional surveyors as the best available evidence of the position of the corner.

C. Description of monument for corner and accessories established to perpetuate locating the position of the corner:
H-1 Standard Kent County Monument

Nail & KC Remon. tag S. side P. Pole	N50°W	55.36'
Chiseled "X" W. end 15" conc. culv.	S40°W	51.32'
Chiseled "X" E. end 15" conc. culv.	S45°E	59.04'
KC Mon. at S 1/4 cor. Sec. 34, T9N, R12W	S90°W	76.62'

STATE OF MICHIGAN
KIRK BREITELS
LAND SURVEYOR
NO 30077
LICENSED LAND SURVEYOR

Signed by Kirk Breitels Date 3/20/95

Surveyor's Michigan License No. 30077

FORM APPROVED BY MICHIGAN STATE BOARD OF PROFESSIONAL SURVEYORS, JAN. 28, 1971
REVISED MAY 14, 1975
REVISED JAN., 1983