SURVEY & MONUMENT DIV.

$7.00
$2.00

JAN 2 4 1996

COMMISSION

KENT COUNTY REMONUMENTATION

LAND CORNER RECORDATION CERTIFICATE
Filing Requirement of Act 74, Mich. P.A. 1970

For corners in KENT COUNTY (County)

	Located In:	Corner Code #
1. Public Land Survey	T 8N R 12W	H-6
	T ___ R ___	
	T ___ R ___	
	T ___ R ___	
2. *Property Controlling*	S ___ T ___ R ___	
in Section	S ___ T ___ R ___	
3. Miscellaneous	S ___ T ___ R ___	
Property in Section	S ___ T ___ R ___	

STATE OF MICHIGAN
COUNTY OF KENT
RECEIVED FOR RECORD
95 DEC 20 AM 8:37
REG. OF DEEDS

8775

Register of Deeds Stamp & File Number

4. Lot No. _____, Recorded Plat _____
5. Private Claims _____

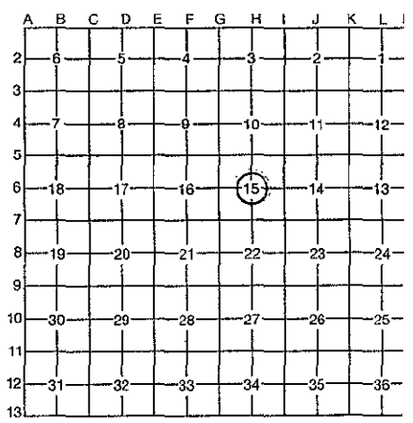

I, Kirk Breitels, in a field survey on Sept. 5, 19 95, do hereby certify that under requirements of P.A. 74, Michigan P.A. of 1970, the corner points mentioned in lines 1 and 2 above were in conformance with regulations and rules therefore as required in the current manual of survey instructions of the United States Department of the Interior, Bureau of Land Management or by a decree of a Court of Law and/or that the corner points mentioned in lines 3, 4 and 5 above were in conformance with the rules of the Michigan Board of Professional Surveyors or by a Decree of a Court of Law; established, re-established, monumented, re-monumented, recovered, found as expressed below:

NOTE: ***Not more than 4 corners, all in the same town and range, may be recorded on this certificate.***

A. Description of original monument and accessories and/or subsequent restoration:

H-6 1837 GLO Not Set
1896-1960 Williams & Works Iron
1969 Kent Co. Wit. 1" Iron in Mon. Box
13" Maple E 57.34'
MBT SSW 54.89'
10" Basswood SSE 98.00'
10" Maple NNW 63.4'
1990 Survey Prien & Newhoff 1 1/2" Solid Iron ??

B. Description of corner evidence found and/or method applied in restoring or reestablishing corner:

H-6 Found 1" Iron Pipe in Mon. Box 0.3' W. & 0.9' S. of intersection of 1/4 lines. Said Iron Pipe fits remaining witnesses from Kent Co. Wit. and agrees ± with Prien & Newhoff and old Williams & Works information.

The 1" Iron Pipe in Mon. Box is accepted by me and is generally accepted by professional surveyors as the best available evidence of the position of the corner.

P.A. 345 1990 KENT COUNTY
PEER APPROVED 9/28/95
CHAIRMAN

C. Description of monument for corner and accessories established to perpetuate locating the position of the corner:

H-6 Set Standard Kent County Monument in place of 1" Iron Pipe inside a Mon. Box

Chiseled "X" N. end conc. culv.	S85°W	18.93'
Chiseled "X" S. end conc. culv.	S45°W	27.23'
Set Nail & KC Remon. tag E. side 18" Ash	S15°E	86.74'
Set Nail & KC Remon. tag N. side 18" Maple	S90°E	57.58'
C/L top of MBT Pedestal	S30°W	53.07'

STATE OF MICHIGAN
KIRK BREITELS
LAND SURVEYOR
NO 30077
LICENSED LAND SURVEYOR

Signed by Kirk Breitels Date 12/6/95

Surveyor's Michigan License No. 30077

FORM APPROVED BY MICHIGAN STATE BOARD OF PROFESSIONAL SURVEYORS, JAN. 28, 1971
REVISED MAY 14, 1975
REVISED JAN., 1983