

Survey & Monumentation

7.00  
2.00

JAN 24 1996 KENT COUNTY REMONUMENTATION

COMMISSION LAND CORNER RECORDATION CERTIFICATE

Filing Requirement of Act 74, Mich. P.A. 1970

For corners in  
KENT COUNTY  
(County)

Located In:

Corner Code #

1. Public Land Survey	T	8N	R	12W	H-8
	T		R		
	T		R		
	T		R		
2. Property Controlling in Section	S		T	R	
	S		T	R	
3. Miscellaneous Property in Section	S		T	R	
	S		T	R	

STATE OF MICHIGAN  
COUNTY OF KENT  
RECEIVED FOR RECORD  
95 DEC 20 AM 8:37  
REG. OF DEEDS  
8782  
Register of Deeds Stamp & File Number

4. Lot No. \_\_\_\_\_, Recorded Plat \_\_\_\_\_  
5. Private Claims \_\_\_\_\_

A	B	C	D	E	F	G	H	I	J	K	L	M
2	6	5	4	3	2							
3												
4	7	8	9	10	11	12						
5												
6	18	17	16	15	14	13						
7												
8	19	20	21	22	23	24						
9												
10	30	29	28	27	26	25						
11												
12	31	32	33	34	35	36						
13												

I, Kirk Breitels, in a field survey on Sept. 7, 1995, do hereby certify that under requirements of P.A. 74, Michigan P.A. of 1970, the corner points mentioned in lines 1 and 2 above were in conformance with regulations and rules therefore as required in the current manual of survey instructions of the United States Department of the Interior, Bureau of Land Management or by a decree of a Court of Law and/or that the corner points mentioned in lines 3, 4 and 5 above were in conformance with the rules of the Michigan Board of Professional Surveyors or by a Decree of a Court of Law; established, re-established, monumented, re-monumented, recovered, found as expressed below:

NOTE: Not more than 4 corners, all in the same town and range, may be recorded on this certificate.

A. Description of original monument and accessories and/or subsequent restoration:

- H-8 1837 GLO Not Set
- 1930-59-68 Williams & Works Stone-Iron-Mon. Box
- 1969 Kent Co. Wits 1" Iron in Mon. Box
- 1978 LCRC #1224 Byl Iron Pipe in Mon. Box  
P. Pole SSE 43.45' NW cor. fnd. NE 110.75' SW cor. fnd. 101.2'
- 1980 LCRC #1363 Stadt 1" Iron in Mon. Box  
SW hse. cor. N45°E 101.15' P. Pole S30°E 43.63' 4" Elm West 22.85'  
On fence line West & C/L blktp. road is 2.5' West

B. Description of corner evidence found and/or method applied in restoring or reestablishing corner:


H-8 Found 1" Iron Pipe in Mon. Box per witnesses that remain from above. Said 1" Iron in Mon. Box is 7.1' W. & 5.1' S. of intersection of 1/4 lines and has been used in surveys by various surveys over the years.

The 1" Iron Pipe in Mon. Box is accepted by me and is generally accepted by professional surveyors as the best available evidence of the position of the corner.

P.A. 345 1990 KENT COUNTY  
PEER APPROVED 9/28/95  
CHAIRMAN Harry Huber

C. Description of monument for corner and accessories established to perpetuate locating the position of the corner:

- H-8 Set Standard Kent County Monument in Mon. Box place of 1" Iron Pipe
- Set Nail & KC Remon. tag E. side P. Pole S30°E 43.69'
- Set Nail & KC Remon. tag S. side 18" Stump S85°W 22.66'
- SW cor. hse. fnd. N60°E 101.22'
- SE cor. hse. fnd. N45°E 110.71'

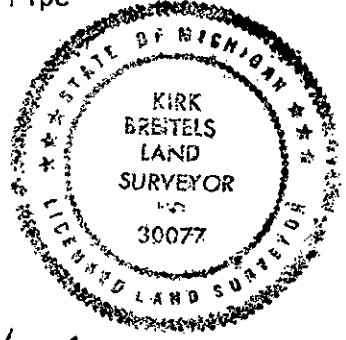

Signed by Kirk Breitels  
30077

Date 12/6/95

Surveyor's Michigan License No. \_\_\_\_\_