$7.00
$2.00

JAN 2 4 1996

COMMISSION

KENT COUNTY REMONUMENTATION

LAND CORNER RECORDATION CERTIFICATE

Filing Requirement of Act 74, Mich. P.A. 1970

For corners in KENT COUNTY (County) Located In: Corner Code #

1. Public Land Survey		T 8N	R 12W	H-12
		T	R	
		T	R	
		T	R	
2. Property Controlling	S	T	R	
in Section	S	T	R	
3. Miscellaneous	S	T	R	
Property in Section	S	T	R	

STATE OF MICHIGAN
COUNTY OF KENT
RECEIVED FOR RECORD
95 DEC 20 AM 8:38
REG. OF DEEDS

8794

Register of Deeds Stamp & File Number

4. Lot No. _____, Recorded Plat _____
5. Private Claims _____

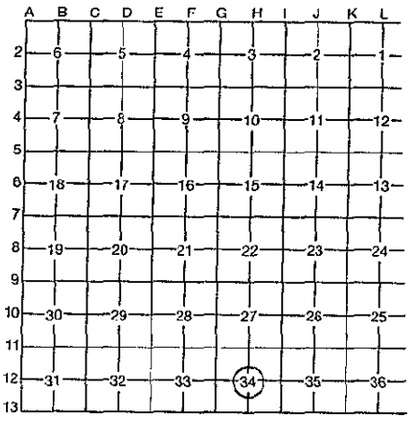

I, Kirk Breitels, in a field survey on Sept. 8, 19 95, do hereby certify that under requirements of P.A. 74, Michigan P.A. of 1970, the corner points mentioned in lines 1 and 2 above were in conformance with regulations and rules therefore as required in the current manual of survey instructions of the United States Department of the Interior, Bureau of Land Management or by a decree of a Court of Law and/or that the corner points mentioned in lines 3, 4 and 5 above were in conformance with the rules of the Michigan Board of Professional Surveyors or by a Decree of a Court of Law; established, re-established, monumented, re-monumented, recovered, found as expressed below:

NOTE: Not more than 4 corners, all in the same town and range, may be recorded on this certificate.

A. Description of original monument and accessories and/or subsequent restoration:

P.A. 345 1990 KENT COUNTY
PEER APPROVED 9/28/95
CHAIRMAN [signature]

H-12 1837 GLO Not Set
1908 Williams & Works Center as shown by fences
1966 Williams & Works Set true center
20" Maple SW 53.23' 16" Ash W 49.40' 30" Maple SSE 77.58'
C/L Road W 6.4'
1968 Williams & Works Mon. Box
1971 LCRC #76 Chambers "T" Iron in Mon. Box
20" Maple S45°W 53.15' SE cor. hse. fnd. N60°W 96.10'
SE cor. hse. fnd. N60°E 109.65'

B. Description of corner evidence found and/or method applied in restoring or reestablishing corner:

H-12 Found "T" Iron in Mon. Box from remaining witnesses from above. Said "T" Iron in Mon. Box is 0.1' W. & 0.3' N. of intersection of 1/4 lines and has been used in many surveys by various surveyors.

The "T" Iron in Mon. Box is accepted by me and is generally accepted by professional surveyors as the best available evidence of the position of the corner.

C. Description of monument for corner and accessories established to perpetuate locating the position of the corner:

H-12 Set Standard Kent County Monument in a Mon. Box in place of the "T" Iron

Set Nail & KC Remon. tag S. side 15" Beech	S80°W	59.94'
Large Spike NW side 36" Maple	S50°W	54.09'
Set Nail & KC Remon. tag W. side 54" Maple	S30°E	79.55'
Set Nail & KC Remon. tag SW side 18" Maple	S45°E	22.58'
SE corner house foundation	N70°W	109.65'
SW corner house foundation	N60°E	96.13'

STATE OF MICHIGAN
KIRK BREITELS
LAND SURVEYOR
NO 30077
LICENSED LAND SURVEYOR

Signed by [signature] Date 12/6/95

Surveyor's Michigan License No. 30077

FORM APPROVED BY MICHIGAN STATE BOARD OF PROFESSIONAL SURVEYORS, JAN. 28, 1971
REVISED MAY 14, 1975
REVISED JAN., 1983