

\$7.00 SEP 18 1995  
\$2.00 COMMISSION

KENT COUNTY REMONUMENTATION

LAND CORNER RECORDATION CERTIFICATE

Filing Requirement of Act 74, Mich. P.A. 1970

For corners in  
KENT COUNTY  
(County)

Located In:

Corner Code #

1. Public Land Survey	T	8N	R	12W	I-5
	T		R		
	T		R		
	T		R		
2. Property Controlling In Section	S		T	R	
	S		T	R	
3. Miscellaneous Property in Section	S		T	R	
	S		T	R	

REG. OF DEEDS


*Lucy J. Bond*

STATE OF MICHIGAN  
COUNTY OF KENT  
RECEIVED FOR RECORD  
95 JUN 29 AM 11:55

8483

Register of Deeds Stamp & File Number

4. Lot No. \_\_\_\_\_, Recorded Plat \_\_\_\_\_  
5. Private Claims \_\_\_\_\_

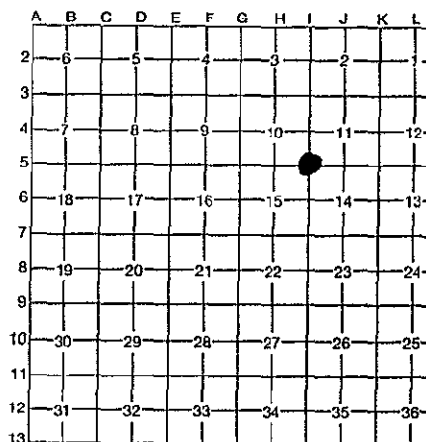

1. Kirk Breitels, in a field survey on Feb. 17, 1995

do hereby certify that under requirements of P.A. 74, Michigan P.A. of 1970, the corner points mentioned in lines 1 and 2 above were in conformance with regulations and rules therefore as required in the current manual of survey instructions of the United States Department of the Interior, Bureau of Land Management or by a decree of a Court of Law and/or that the corner points mentioned in lines 3, 4 and 5 above were in conformance with the rules of the Michigan Board of Professional Surveyors or by a Decree of a Court of Law; established, re-established, monumented, re-monumented, recovered, found as expressed below:

NOTE: Not more than 4 corners, all in the same town and range, may be recorded on this certificate.

A. Description of original monument and accessories and/or subsequent restoration:

I-5	1838	GLO	Whitcomb	Set Post
	1935	Kent Co. Wit.		Conc. Mon.
	1980	LCRC #1392	VanLaar	Rerod
	1980	LCRC #1618	VanKooten	1/2" Solid Iron
	1981	LCRC #2563	Bueche	Set Kent County Monument
	1990	LCRC #5391	Starr	Kent County Monument

The position of this corner was previously approved by the Kent County Remonumentation Peer Group, monumented by John C. Bueche on 12/4/81 and was recorded per LCRC #2563.

B. Description of corner evidence found and/or method applied in restoring or reestablishing corner:

I-5 Found standard Kent Co. Mon. (Harrison) per witnesses from above LCRC as set by John C. Bueche in place of the 1/2" x 18" Rerod on top of a conc. mon. he found. Said Rerod and conc. mon. checks with Kent Co. Wit. and LCRC's #1392 & #1618.

LCRC #2563 & #5391

NE cor. house foundation	S55°E	121.55'
SW cor. house foundation	S40°E	118.03'
SE cor. garage foundation	N45°W	119.64'
Nail & KC Remon. tag W. side 26" Maple	S20°E	92.47'
SW cor. garage, brick	N15°E	76.68'
Nail & KC Remon. tag S. side 8" Ash	N45°W	42.80'

P.A. 345 1990 KENT COUNTY  
PEER APPROVED 6/22/95  
CHAIRMAN *Harry Huber*

On C/L bit. road South; C/L blktp. E & W is North 2' m/l

The selected location is accepted by me and is generally accepted by professional surveyors as the best available evidence of the position of the original corner.

C. Description of monument for corner and accessories established to perpetuate locating the position of the corner:

I-5 Standard Kent County Monument			
NE cor. house foundation	S55°E	121.55'	
SW cor. house foundation	S40°E	118.09'	
SE cor. garage foundation - addition	N35°W	111.25'	
New Nail & KC Remon. tag W. side 30" Maple	S20°E	92.37'	
SW cor. garage, brick	N15°E	76.68'	
New Nail & KC Remon. tag S. side 12" Ash	N45°W	42.95'	
On C/L bit. road South; C/L blktp. E & W is North 2' m/l			



Signed by *Kirk Breitels*  
Surveyor's Michigan License No. 30077

Date 6/22/95