

\$7.00  
\$2.00

SEP 1 3 1985

KENT COUNTY REMONUMENTATION

COMMISSIONER

LAND CORNER RECORDATION CERTIFICATE

Filing Requirement of Act 74, Mich. P.A. 1970

For corners in  
KENT COUNTY

(County)	Located In:	Corner Code #
1. Public Land Survey	T 8N R 12W	I-8
	T R	
	T R	
	T R	
2. Property Controlling in Section	S T R	
	S T R	
3. Miscellaneous Property in Sec.	S T R	
	S T R	

STATE OF MICHIGAN  
COUNTY OF KENT  
RECEIVED FOR RECORD  
95 JUN 29 AM 11:56  
REG. OF DEEDS  
8486

Register of Deeds Stamp & File Number

4. Lot No. \_\_\_\_\_, Recorded Plat \_\_\_\_\_

5. Private Claims \_\_\_\_\_

I, Kirk Breitels, in a field survey on March 2, 19 95

do hereby certify that under requirements of P.A. 74, Michigan P.A. of 1970, the corner points mentioned in lines 1 and 2 above were in conformance with regulations and rules therefore as required in the current manual of survey instructions of the United States Department of the Interior, Bureau of Land Management or by a decree of a Court of Law and/or that the corner points mentioned in lines 3, 4 and 5 above were in conformance with the rules of the Michigan Board of Land Surveyors or by a Decree of a Court of Law; established, re-established, monumented, re-monumented, recovered, found as expressed below:

**NOTE: Not more than 4 corners, all in the same town and range, may be recorded on this certificate.**

	A	B	C	D	E	F	G	H	I	J	K	L	M
2	6	5	4	3	2	1							
3													
4	7	8	9	10	11	12							
5													
6	18	17	16	15	14	13							
7													
8	19	20	21	22	23	24							
9													
10	30	29	28	27	26	25							
11													
12	31	32	33	34	35	36							
13													

A. Description of original monument and accessories and/or subsequent restoration:

I-8	1838	GLO	Whitcomb	Set Post
	1935	Kent Co. Wit.		Iron
	1972	LCRC #255	Spicer	1" Iron
	1981	LCRC #2564	Bueche	Set Kent County Monument
	1990	LCRC #5394	Starr	Kent County Monument

The position of this corner was previously approved by the Kent County Remonumentation Peer Group, monumented by John C. Bueche on 12/3/81 and was recorded per LCRC #2564.

B. Description of corner evidence found and/or method applied in restoring or reestablishing corner:  
I-8 Found standard Kent Co. Mon. (Harrison) per witnesses from above LCRC as set by John C. Bueche in place of the 1 1/4" Iron over a 3/4" Iron and another 3/4" Iron he found. All Irons check with Kent Co. Wit. and LCRC #255.

LCRC #2564 & #5394

Nail & KC Remon. tag E. side	30" Walnut	S15°W	87.67'
Nail & KC Remon. tag S. side	12" W. Cherry	N90°E	44.35'
Nail & KC Remon. tag S. side	8" Birch	N75°W	72.88'
SE cor. house foundation		N35°W	212.13'

C/L North - South bit. road is 1' East  
On tree line East

P.A. 345 1990 KENT COUNTY  
PEER APPROVED 6/22/95  
CHAIRMAN Harry Huber


The selected location is accepted by me and is generally accepted by professional surveyors as the best available evidence of the position of the original corner.

C. Description of monument for corner and accessories established to perpetuate locating the position of the corner:

I-8 Standard Kent County Monument

New Nail & KC Remon. tag E. side	36" Walnut	S15°W	87.56'
New Nail & KC Remon. tag S. side	14" W. Cherry	N90°E	44.35'
New Nail & KC Remon. tag S. side	12" Birch	N75°W	72.94'
SE cor. house foundation		N35°W	212.13'

C/L North - South bit. road is 1' East  
On tree line East

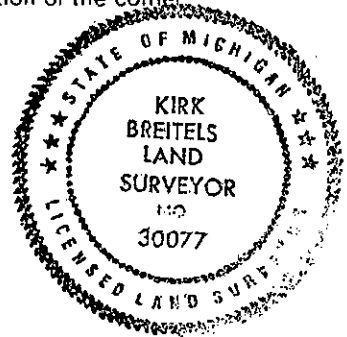

Signed by Kirk Breitels Date 6/22/95  
Surveyor's Michigan License No. 30077