

SURVEY & REMONUMENTATION

APR 28 1995

COMMISSION

KENT COUNTY REMONUMENTATION

LAND CORNER RECORDATION CERTIFICATE
Filing Requirement of Act 74, Mich. P.A. 1970

STATE OF MICHIGAN
 COUNTY OF KENT
 RECEIVED FOR RECORD

94 DEC 27 AM 9:04

For corners in
KENT COUNTY

(County)	Located In:	Corner Code #
1. Public Land Survey	T <u>8N</u> R <u>12W</u>	<u>I-11</u>
	T _____ R _____	_____
	T _____ R _____	_____
	T _____ R _____	_____
2. Property Controlling in Section	S _____ T _____ R _____	_____
	S _____ T _____ R _____	_____
3. Miscellaneous Property in Sec.	S _____ T _____ R _____	_____
	S _____ T _____ R _____	_____

W. J. Bond
 REG. OF DEEDS

7901

Register of Deeds Stamp & File Number

4. Lot No. _____, Recorded Plat _____
 5. Private Claims _____

	A	B	C	D	E	F	G	H	I	J	K	L	M
2	6	5	4	3	2	1							
3													
4	7	8	9	10	11	12							
5													
6	18	17	16	15	14	13							
7													
8	19	20	21	22	23	24							
9													
10	30	29	28	27	26	25							
11													
12	31	32	33	34	35	36							
13													

I, William R. Byl, in a field survey on Aug. 1, 19 94, do hereby certify that under requirements of P.A. 74, Michigan P.A. of 1970, the corner points mentioned in lines 1 and 2 above were in conformance with regulations and rules therefore as required in the current manual of survey instructions of the United States Department of the Interior, Bureau of Land Management or by a decree of a Court of Law and/or that the corner points mentioned in lines 3, 4 and 5 above were in conformance with the rules of the Michigan Board of Land Surveyors or by a Decree of a Court of Law; established, re-established, monumented, re-monumented, recovered, found as expressed below:

NOTE: Not more than 4 corners, all in the same town and range, may be recorded on this certificate.

A. Description of original monument and accessories and/or subsequent restoration:

I-11	1837	GLO	Whitcomb	Set Post
	1952	Kent Co. Wit.		Conc. Monument
	1976	LCRC #987	Nederveld	3/4" Iron
	1981	LCRC #2390	Bueche	Set Kent County Monument
	1990	LCRC #5397	Starr	Kent County Monument

The position of this corner was previously approved by the Kent County Remonumentation Peer Group, monumented by John C. Bueche on 11/21/81 and was recorded per LCRC #2390

B. Description of corner evidence found and/or method applied in restoring or reestablishing corner:

I-11 Found standard Kent Co. Mon. (Harrison) per witnesses from above LCRC as set by John C. Bueche in place of the 1/2" x 18" Rerod and Conc. Monument he found. Said Rerod and Conc. Monument checks with Kent Co. Wit. and LCRC #987.


LCRC #2390	LCRC #5397
C/L top tele. ped. S48°E 58.62'	same witnesses as LCRC #2390
KC Tag & Nail S. side 16" Hickory N90°E 179.05'	
S. end CMP S35°E 34.54'	
N. end CMP S80°E 22.18'	
S. end CMP S80°W 19.10'	
N. end CMP N40°W 25.00'	

P.A. 345 1990 KENT COUNTY
 PEER APPROVED 12/22/99
 CHAIRMAN *Harry Bueche*

C/L of N & S bit. road is 2' E.
 The selected location is accepted by me and is generally accepted by professional surveyors as the best available evidence of the position of the original corner.

C. Description of monument for corner and accessories established to perpetuate locating the position of the corner:

I-11 Standard Kent County Monument	
C/L top telephone pedestal	S48°E 58.76'
New KC Remon. tag & nail S. side 16" Hickory	N90°E 179.06'
S. end CMP	S80°W 19.00'
N. end CMP	N40°W 25.00'
Set KC Remon. tag & nail NW side fence post	S50°W 39.96'
C/L of N & S bit. road is 2' E.	

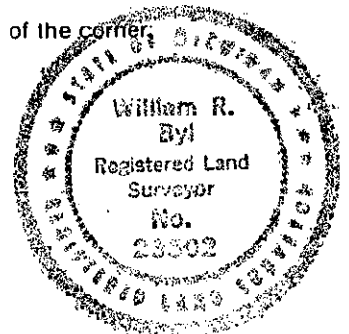

Signed by *W. R. Byl*
 Surveyor's Michigan License No. 23502

Date 12/07/94
 FORM APPROVED BY MICHIGAN STATE BOARD OF LAND SURVEYORS, JAN. 28, 1971
 REVISED MAY 14, 1975
 REVISED JAN., 1983