

SURVEY & REMONUMENTATION

APR 28 1995

COMMISSION

KENT COUNTY REMONUMENTATION

LAND CORNER RECORDATION CERTIFICATE
Filing Requirement of Act 74, Mich. P.A. 1970

STATE OF MICHIGAN
COUNTY OF KENT
RECEIVED FOR RECORD

94 DEC 27 AM 9:04

For corners in
KENT COUNTY
(County)

Located In: Corner Code #

1. Public Land Survey	T <u>8N</u> R <u>12W</u>	<u>I-13</u>
	T _____ R _____	_____
	T _____ R _____	_____
	T _____ R _____	_____
2. Property Controlling in Section	S _____ T _____ R _____	_____
	S _____ T _____ R _____	_____
3. Miscellaneous Property in Sec.	S _____ T _____ R _____	_____
	S _____ T _____ R _____	_____

Lucy Bond
REG. OF DEEDS

7903

Register of Deeds Stamp & File Number

- 4. Lot No. _____, Recorded Plat _____
- 5. Private Claims _____

	A	B	C	D	E	F	G	H	I	J	K	L	M
2	6	5	4	3	2	1							
3													
4	7	8	9	10	11	12							
5													
6	10	17	16	15	14	13							
7													
8	19	20	21	22	23	24							
9													
10	30	29	28	27	26	25							
11													
12	31	32	33	34	35	36							
13													

I, William R. Byl, in a field survey on July 27, 19 94, do hereby certify that under requirements of P.A. 74, Michigan P.A. of 1970, the corner points mentioned in lines 1 and 2 above were in conformance with regulations and rules therefore as required in the current manual of survey instructions of the United States Department of the Interior, Bureau of Land Management or by a decree of a Court of Law and/or that the corner points mentioned in lines 3, 4 and 5 above were in conformance with the rules of the Michigan Board of Land Surveyors or by a Decree of a Court of Law; established, re-established, monumented, re-monumented, recovered, found as expressed below:

NOTE: Not more than 4 corners, all in the same town and range, may be recorded on this certificate.

A. Description of original monument and accessories and/or subsequent restoration:

I-13	1836	GLO	Brookfield	Set Post
		Kent Co. Wit.		Conc. Monument
1972		LCRC #290	VanKooten	1/2" Iron
1981		LCRC #1761	Merdzinski	Set Kent County Monument
1990		LCRC #	Starr	Kent County Monument

P.A. 945 1990 KENT COUNTY
PEER APPROVED 12/22/94
CHAIRMAN *[Signature]*

The position of this corner was previously approved by the Kent County Remonumentation Peer Group, monumented by John A. Merdzinski on 1/21/81 and was recorded per LCRC #1761

B. Description of corner evidence found and/or method applied in restoring or reestablishing corner:


I-13 Found standard Kent Co. Mon. (Harrison) per witnesses from above LCRC as set by John A. Merdzinski in place of the 1/2" x 18" Iron he found over a Conc. Monument. Said Iron and Conc. Monument check with Kene Co. Wit. and LCRC #290.

<u>LCRC #1761</u>	<u>LCRC #5399</u>
Nail & tag 4" Ash N50°W 75.11'	C/L top of tele. box N45°W 61.93'
Nail & tag 24" Apple N35°E 122.48'	Nail & KC tag S. side Lt. Pole N55°E 39.40'
Nail & tag P. Pole S55°E 113.56'	Nail & KC tag N. side P. Pole S55°W 113.56'
Nail & tag 16" Walnut S20°E 32.23'	Nail & KC tag N. side P. Pole S20°E 59.17'
Nail & tag 14" Walnut S65°W 54.98'	NE cor. conc. fdn. for green house S20°E 72.49'
PK in conc. curb N40°W 34.90'	KC Mon. East 64.81'
Iron East 64.79'	On C/L E-W-N roads

The selected location is accepted by me and is generally accepted by professional surveyors as the best available evidence of the position of the original corner.

C. Description of monument for corner and accessories established to perpetuate locating the position of the corner:

I-13 Standard Kent County Monument		
C/L top of tele. box	N45°W	61.93'
Nail & KC tag S. side Lt. Pole	N55°E	54.63'
Nail & KC tag N. side P. Pole	S20°E	59.22'
NE cor. conc. fdn. for green house	S20°E	72.49'
KC Mon. (I-1, T7N, R12W)	S90°E	64.81'
On C/L E-W-N roads		

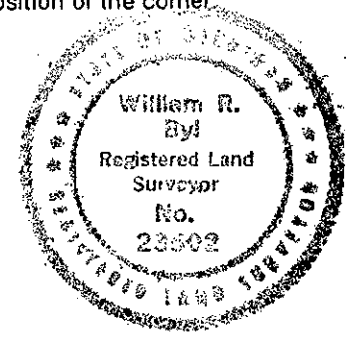

Signed by *W. R. Byl*
Surveyor's Michigan License No. 23502

Date 12/07/94