

JAN 24 1996

KENT COUNTY REMONUMENTATION

\$7.00  
\$2.00

COMMISSION

LAND CORNER RECORDATION CERTIFICATE

Filing Requirement of Act 74, Mich. P.A. 1970

For corners in  
KENT COUNTY  
(County)

Located In:

Corner Code #

1. Public Land Survey	T	8N	R	12W	J-2
	T		R		
	T		R		
	T		R		
2. Property Controlling in Section	S		T	R	
	S		T	R	
3. Miscellaneous Property in Section	S		T	R	
	S		T	R	

REG. OF DEEDS  
*[Signature]*  
8764

STATE OF MICHIGAN  
COUNTY OF KENT  
RECEIVED FOR RECORD  
95 DEC 20 AM 8:36

Register of Deeds Stamp & File Number

4. Lot No. \_\_\_\_\_, Recorded Plat \_\_\_\_\_  
5. Private Claims \_\_\_\_\_

A	B	C	D	E	F	G	H	I	J	K	L	M
2	6	5	4	3					2			
3												
4	7	6	9	10	11	12						
5												
6	18	17	16	15	14	13						
7												
8	19	20	21	22	23	24						
9												
10	30	29	28	27	26	25						
11												
12	31	32	33	34	35	36						
13												

I, Kirk Breitels, in a field survey on Sept. 5, 1995, do hereby certify that under requirements of P.A. 74, Michigan P.A. of 1970, the corner points mentioned in lines 1 and 2 above were in conformance with regulations and rules therefore as required in the current manual of survey instructions of the United States Department of the Interior, Bureau of Land Management or by a decree of a Court of Law and/or that the corner points mentioned in lines 3, 4 and 5 above were in conformance with the rules of the Michigan Board of Professional Surveyors or by a Decree of a Court of Law; established, re-established, monumented, re-monumented, recovered, found as expressed below:

NOTE: Not more than 4 corners, all in the same town and range, may be recorded on this certificate.

A. Description of original monument and accessories and/or subsequent restoration:

J-2 1837 GLO Not Set	1988 Survey Roosien Stone
1944-52 Williams & Works Stone	26" Maple N05°W 18.37'
Kent Co. Wit. Stone	10" Maple N50°E 29.01'
C/L 22" Beech SW 32.60'	26" Maple S40°W 32.27'
14" Ironwood SW 27.75'	
C/L 22" Beech NW 18.37'	

P.A. 345 1990 KENT COUNTY  
PEER APPROVED 9/28/95  
CHAIRMAN *[Signature]*

B. Description of corner evidence found and/or method applied in restoring or reestablishing corner:

J-2 Found Pointed Stone at remains of fences N-S & E. Stone fits remaining witnesses from above along with measurements and angles from various surveys. Stone is 1.0' E. and 0.5' S. of true intersection of 1/4 lines.


The Pointed Stone is accepted by me and is generally accepted by professional surveyors as the best available evidence of the position of the corner.

C. Description of monument for corner and accessories established to perpetuate locating the position of the corner:

J-2 Set Standard Kent County Monument in place of the Pointed Stone

Set Nail & KC Remon. tag W. side 20" Cherry	S35°E	8.84'
Set Nail & KC Remon. tag W. side 36" Beech	N20°W	18.40'
Set Nail & KC Remon. tag NW side 36" Beech	S40°W	32.18'
Set Nail & KC Remon. tag S. side 20" Ironwood	S80°W	27.78'
Set Nail & KC Remon. tag SE side 15" Maple	N45°E	28.47'

On fence lines N-S-E

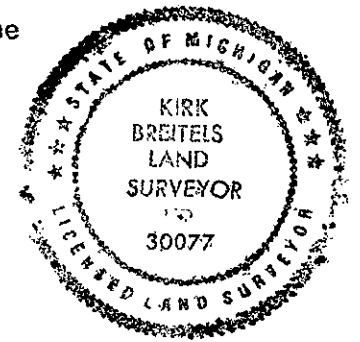

Signed by Kirk Breitels

Date 12/6/95

Surveyor's Michigan License No. 30077