

JAN 24 1996

KENT COUNTY REMONUMENTATION

\$7.00
\$2.00

COMMISSION

LAND CORNER RECORDATION CERTIFICATE
Filing Requirement of Act 74, Mich. P.A. 1970

For corners in
KENT COUNTY
(County)

Located In:

Corner Code #

1. Public Land Survey	T	8N	R	12W	J-4
	T		R		
	T		R		
	T		R		
2. Property Controlling in Section	S		T	R	
	S		T	R	
3. Miscellaneous Property in Section	S		T	R	
	S		T	R	

REG. OF DEEDS

Lucy Bond

95 DEC 20 AM 8:37

STATE OF MICHIGAN
COUNTY OF KENT
RECEIVED FOR RECORD

8773

Register of Deeds Stamp & File Number

- 4. Lot No. _____, Recorded Plat _____
- 5. Private Claims _____

A	B	C	D	E	F	G	H	I	J	K	L
2	6	5	4	3	2	1					
3											
4	7	8	9	10	11	12					
5											
6	18	17	16	15	14	13					
7											
8	19	20	21	22	23	24					
9											
10	30	29	28	27	26	25					
11											
12	31	32	33	34	35	36					
13											

I, Kirk Breitels, in a field survey on Sept. 6, 1995,

do hereby certify that under requirements of P.A. 74, Michigan P.A. of 1970, the corner points mentioned in lines 1 and 2 above were in conformance with regulations and rules therefore as required in the current manual of survey instructions of the United States Department of the Interior, Bureau of Land Management or by a decree of a Court of Law and/or that the corner points mentioned in lines 3, 4 and 5 above were in conformance with the rules of the Michigan Board of Professional Surveyors or by a Decree of a Court of Law; established, re-established, monumented, re-monumented, recovered, found as expressed below:

NOTE: Not more than 4 corners, all in the same town and range, may be recorded on this certificate.

A. Description of original monument and accessories and/or subsequent restoration:

- J-4 1837 GLO Not Set
- 1926 Williams & Works Fence lines
- 1929-45 Williams & Works Iron
- Kent Co. Wit. 1/2" Iron
- 24" Cherry NE 24.15'
- 30" Tri. B'wood NW 11.85'
- 1980 LCRC #2083 Nederveid 1/2" Rd. Iron
- 14" DbI. Cherry ENE 24.35'
- 30" Tri. B'wood NNW 11.85'
- 8" Locust WNW 9.03'
- Exxel Eng. - used per LCRC #2083
- Iron is 7.6' N. & 11.3' E. of true

B. Description of corner evidence found and/or method applied in restoring or reestablishing corner:


J-4 Found 1/2" Round Iron on remains of fences to East & North. Round Iron fits remaining witnesses of those above and agrees with dimensions and angles of various surveys (±). Round Iron is 7.7' N. & 11.1' E. of a true intersection of 1/4 lines.

The 1/2" Round Iron is accepted by me and is generally accepted by professional surveyors as the best available evidence of the position of the corner.

P.A. 345 1990 KENT COUNTY
PEER APPROVED 9/28/95
CHAIRMAN [Signature]

C. Description of monument for corner and accessories established to perpetuate locating the position of the corner:

- J-4 Set Standard Kent County Monument in place of 1/2" Round Iron.
- Set Nail & KC Remon. tag E. side Tri. 30" Basswood N00°E 11.07'
- Set Nail & KC Remon. tag NE side 10" Locust N50°W 8.98'
- Set Nail & KC Remon. tag NW side 12" Apple S40°W 37.59'
- Set Nail & KC Remon. tag N. side Tw. 18" Cherry N85°E 24.24'

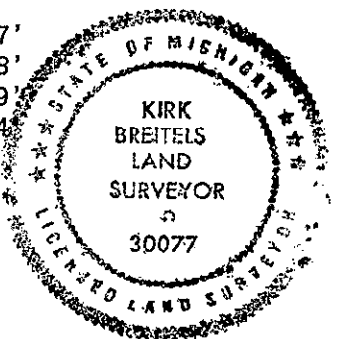

Signed by Kirk Breitels

Date 12/6/95

Surveyor's Michigan License No. 30077