

\$7.00
\$2.00 SEP 1 1995
COMMISS

KENT COUNTY REMONUMENTATION

LAND CORNER RECORDATION CERTIFICATE
Filing Requirement of Act 74, Mich. P.A. 1970

For corners in
KENT COUNTY
(County)

Located In:


Corner Code #

1. Public Land Survey	T	8N	R	12W	J-5
	T		R		
	T		R		
	T		R		
2. Property Controlling in Section	S		T		
	S		T		
3. Miscellaneous Property in Section	S		T		
	S		T		

STATE OF MICHIGAN
COUNTY OF KENT
RECEIVED FOR RECORD
95 JUN 29 AM 11:56
REG. OF DEEDS
8491

Register of Deeds Stamp & File Number

4. Lot No. _____, Recorded Plat _____
5. Private Claims _____

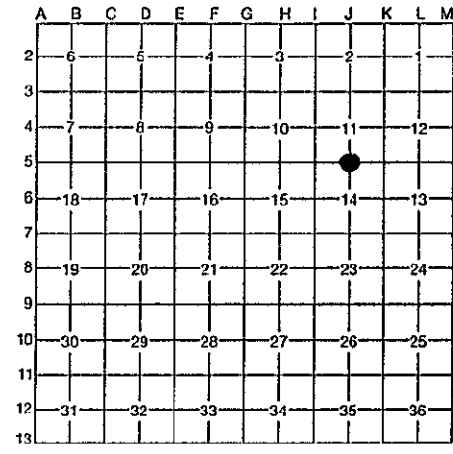

I, Kirk Breitels, in a field survey on Feb. 24, 1995, do hereby certify that under requirements of P.A. 74, Michigan P.A. of 1970, the corner points mentioned in lines 1 and 2 above were in conformance with regulations and rules therefore as required in the current manual of survey instructions of the United States Department of the Interior, Bureau of Land Management or by a decree of a Court of Law and/or that the corner points mentioned in lines 3, 4 and 5 above were in conformance with the rules of the Michigan Board of Professional Surveyors or by a Decree of a Court of Law; established, re-established, monumented, re-monumented, recovered, found as expressed below:

NOTE: Not more than 4 corners, all in the same town and range, may be recorded on this certificate.

A. Description of original monument and accessories and/or subsequent restoration:

J-5	1838	GLO	Whitcomb	Set Post
	1935	Kent Co. Wit.		Conc. Mon.
	1980	LCRC #1392	VanLaar	Re-rod
	1981	LCRC #2565	Bueche	Set Kent County Monument
	1990	LCRC #5401	Starr	Kent County Monument

The position of this corner was previously approved by the Kent County Remonumentation Peer Group, monumented by John C. Bueche on 12/4/81 and was recorded per LCRC #2565.

B. Description of corner evidence found and/or method applied in restoring or reestablishing corner:

J-5 Found standard Kent Co. Mon. (Harrison) per witnesses from above LCRC as set by John C. Bueche in place of the Re-rod over a conc. mon. he found. Both Re-rod and conc. mon. checks with Kent Co. Wit. and LCRC #1392.

LCRC #2565 & #5401

KC Remon. tag & Nail W. side P. Pole	N55°E	79.62'
KC Remon. tag & Nail N. side Tel. Pole	S80°E	140.55'
"X" cut W. end conc. culv.	S75°E	106.87'
KC Remon. tag & Nail S. side 6" Tree	N75°W	56.25'

P.A. 345 1990 KENT COUNTY
PEER APPROVED 6/22/95
CHAIRMAN Harry Huber

The selected location is accepted by me and is generally accepted by professional surveyors as the best available evidence of the position of the original corner.

C. Description of monument for corner and accessories established to perpetuate locating the position of the corner:

J-5 Standard Kent County Monument

KC Remon. tag & Nail W. side P. Pole	N55°E	79.62'
KC Remon. tag & Nail N. side Tel. Pole	S80°E	140.55'
"X" cut W. end conc. culv.	S75°E	106.87'
New KC Remon. tag & Nail S. side 12" Tree	N75°W	56.20'

C/L E-W bit road is 4' South; Field division S.; On C/L 2 track N.



Signed by Kirk Breitels

Date 6/22/95

Surveyor's Michigan License No. 30077