

**SURVEY &  
REMONUMENTATION**

APR 28 1995

COMMISSION

KENT COUNTY REMONUMENTATION

**LAND CORNER RECORDATION CERTIFICATE**  
Filing Requirement of Act 74, Mich. P.A. 1970

STATE OF MICHIGAN  
COUNTY OF KENT  
RECEIVED FOR RECORD  
94 DEC 27 AM 9:04

For corners in  
KENT COUNTY

(County)

Located In:

Corner Code #

- |                                    |                          |             |
|------------------------------------|--------------------------|-------------|
| 1. Public Land Survey              | T <u>8N</u> R <u>12W</u> | <u>J-11</u> |
|                                    | T _____ R _____          | _____       |
|                                    | T _____ R _____          | _____       |
|                                    | T _____ R _____          | _____       |
| 2. Property Controlling in Section | S _____ T _____ R _____  | _____       |
|                                    | S _____ T _____ R _____  | _____       |
| 3. Miscellaneous Property in Sec.  | S _____ T _____ R _____  | _____       |
|                                    | S _____ T _____ R _____  | _____       |

*Lucy Bond*  
REG. OF DEEDS

7904

Register of Deeds Stamp & File Number

4. Lot No. \_\_\_\_\_, Recorded Plat \_\_\_\_\_  
5. Private Claims \_\_\_\_\_

A	B	C	D	E	F	G	H	I	J	K	L	M
2	6	5	4	3	2	1						
3												
4	7	8	9	10	11	12						
5												
6	18	17	16	15	14	13						
7												
8	19	20	21	22	23	24						
9												
10	30	29	28	27	26	25						
11												
12	31	32	33	34	35	36						
13												

I, William R. Byl, in a field survey on Aug. 1, 19 94, do hereby certify that under requirements of P.A. 74, Michigan P.A. of 1970, the corner points mentioned in lines 1 and 2 above were in conformance with regulations and rules therefore as required in the current manual of survey instructions of the United States Department of the Interior, Bureau of Land Management or by a decree of a Court of Law and/or that the corner points mentioned in lines 3, 4 and 5 above were in conformance with the rules of the Michigan Board of Land Surveyors or by a Decree of a Court of Law; established, re-established, monumented, re-monumented, recovered, found as expressed below:

**NOTE: Not more than 4 corners, all in the same town and range, may be recorded on this certificate.**

A. Description of original monument and accessories and/or subsequent restoration:

J-11	1838	GLO	Whitcomb	Set Post
	1959	Kent Co. Wit.		Stone
	1975	LCRC #791	Hooth	Copperweld in mon. box
	1980	LCRC #1452	Merdzinski	Set Kent County Monument
	1990	LCRC #5404	Starr	Kent County Monument

P.A. 345 1990 KENT COUNTY

PEER APPROVED 12/22/94

CHAIRMAN *Harry Huber*

The position of this corner was previously approved by the Kent County Remonumentation Peer Group, monumented by John A. Merdzinski on 10/27/80 and was recorded per LCRC #1452

B. Description of corner evidence found and/or method applied in restoring or reestablishing corner:

J-11 Found standard Kent Co. Mon. (Harrison) per witnesses from above LCRC as set by John A. Merdzinski in place of the Copperweld he found inside a mon. box. Said Copperweld in mon. box checks with Kent Co. Wit. and LCRC #791.


<u>LCRC #1452</u>		<u>LCRC #5404</u>
SE cor. frame hse. #4409	N25°W 174.68'	same witnesses as LCRC #1452
NE cor. brick hse.	S65°W 107.70'	
NW cor. brick garage	S33°E 136.60'	
Nail & KC tag S. side P. Pole	S60°E 35.66'	
Nail & KC tag N. side 12" DbL Cherry	N80°W 47.23'	
Nail & KC tag S. side 10" Pear	N60°E 39.68'	

The selected location is accepted by me and is generally accepted by professional surveyors as the best available evidence of the position of the original corner.

C. Description of monument for corner and accessories established to perpetuate locating the position of the corner:

J-11 Standard Kent County Monument

SE cor. frame hse. #4409 (3' above grd.)	N25°W	174.68'
NE cor. brick hse. (4.8' above grd.)	S65°W	107.70'
NW cor. brick garage (at grd.)	S33°E	136.60'
Nail & KC Remon. tag S. side P. Pole	S60°E	35.66'
Nail & KC Remon. tag S. side 10" Pear	N60°E	39.65'
C/L N-S bit. rd. is 0.6' E.; Fence line E. is 9' N.		

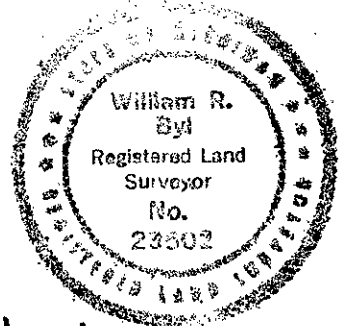

Signed by *William R. Byl*  
Surveyor's Michigan License No. 23502

Date 12/07/94