

JAN 24 1996

KENT COUNTY REMONUMENTATION

COMMISSION

LAND CORNER RECORDATION CERTIFICATE
Filing Requirement of Act 74, Mich. P.A. 1970

For corners in
KENT COUNTY
(County)

Located In:

Corner Code #

- | | | | | | |
|--------------------------------------|---|----|---|-----|------|
| 1. Public Land Survey | T | 8N | R | 12W | J-12 |
| | T | | R | | |
| | T | | R | | |
| | T | | R | | |
| 2. Property Controlling in Section | S | | T | R | |
| | S | | T | R | |
| 3. Miscellaneous Property in Section | S | | T | R | |
| | S | | T | R | |

REG. OF DEEDS

Lucy Standa

95 DEC 26 PM 12:43

STATE OF MICHIGAN
COUNTY OF KENT
RECEIVED FOR RECORD

8870

Register of Deeds Stamp & File Number

4. Lot No. _____, Recorded Plat _____
5. Private Claims _____

| A | B | C | D | E | F | G | H | I | J | K | L | M |
|----|----|----|----|----|----|----|---|---|---|---|---|---|
| 2 | 6 | 5 | 4 | 3 | 2 | 1 | | | | | | |
| 3 | | | | | | | | | | | | |
| 4 | 7 | 8 | 9 | 10 | 11 | 12 | | | | | | |
| 5 | | | | | | | | | | | | |
| 6 | 18 | 17 | 16 | 15 | 14 | 13 | | | | | | |
| 7 | | | | | | | | | | | | |
| 8 | 19 | 20 | 21 | 22 | 23 | 24 | | | | | | |
| 9 | | | | | | | | | | | | |
| 10 | 30 | 29 | 28 | 27 | 26 | 25 | | | | | | |
| 11 | | | | | | | | | | | | |
| 12 | 31 | 32 | 33 | 34 | 35 | 36 | | | | | | |
| 13 | | | | | | | | | | | | |

I, Kirk Breitels, in a field survey on Dec. 15, 1994

do hereby certify that under requirements of P.A. 74, Michigan P.A. of 1970, the corner points mentioned in lines 1 and 2 above were in conformance with regulations and rules therefore as required in the current manual of survey instructions of the United States Department of the Interior, Bureau of Land Management or by a decree of a Court of Law and/or that the corner points mentioned in lines 3, 4 and 5 above were in conformance with the rules of the Michigan Board of Professional Surveyors or by a Decree of a Court of Law; established, re-established, monumented, re-monumented, recovered, found as expressed below:

NOTE: Not more than 4 corners, all in the same town and range, may be recorded on this certificate.

A. Description of original monument and accessories and/or subsequent restoration:

- J-12 1838 GLO Not Set
- 1918-60 Williams & Works "Point" - Iron - Monument
- 1961 Kent Co. Wit. Conc. Monument
- P.P. WSW 262.70' P.P. SE 75.63' Fence Post E. 31.95'
- 1975 LCRC #789 Hooth Set Copperweld Rod in mon. box in place of Conc. Mon.
- P. Pole S40°E 75.63' 4" Elm East 74.95'

B. Description of corner evidence found and/or method applied in restoring or reestablishing corner:


J-12 Found Copperweld Rod in mon. box over remains of Conc. Mon. that fits the remaining witnesses of those above. Said Copperweld Rod is 3.5' S. and 0.5' W. from true intersection of 1/4 lines.

The Copperweld Rod in mon. box is accepted by me and is generally accepted by professional surveyors as the best available evidence of the position of the corner.

P.A. 345 1990 KENT COUNTY
PEER APPROVED 12/15/94
CHAIRMAN *Henry Tubere*

C. Description of monument for corner and accessories established to perpetuate locating the position of the corner:

- J-12 Set Standard Kent County Monument over remains of Conc. Mon. in Mon. Box in place of the Copperweld Rod in mon. box
- Set Nail & KC Remon. tag in P. Pole S40°E 75.60'
- "X" cut top N. end culvert N45°W 24.73'
- "X" cut top S. end culvert S85°W 17.47'
- Set Nail & KC Remon. tag in 10" Elm S80°E 30.50'

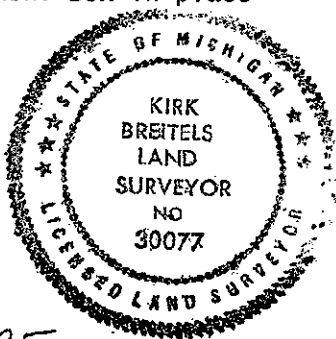

Signed by *Kirk Breitels*

Date 12/14/95

Surveyor's Michigan License No. 30077