

\$7.00
\$2.00

SEP 18 1995

KENT COUNTY REMONUMENTATION

COMMISSIONER

LAND CORNER RECORDATION CERTIFICATE
Filing Requirement of Act 74, Mich. P.A. 1970

For corners in
KENT COUNTY
(County)

Located In:


Corner Code #

1. Public Land Survey	T	8N	R	12W	K-3
	T		R		
	T		R		
	T		R		
2. Property Controlling in Section	S		T	R	
	S		T	R	
3. Miscellaneous Property in Section	S		T	R	
	S		T	R	

STATE OF MICHIGAN
COUNTY OF KENT
RECEIVED FOR RECORD
95 JUN 29 AM 11:55
REG. OF DEEDS
8496

Register of Deeds Stamp & File Number

4. Lot No. _____, Recorded Plat _____
5. Private Claims _____

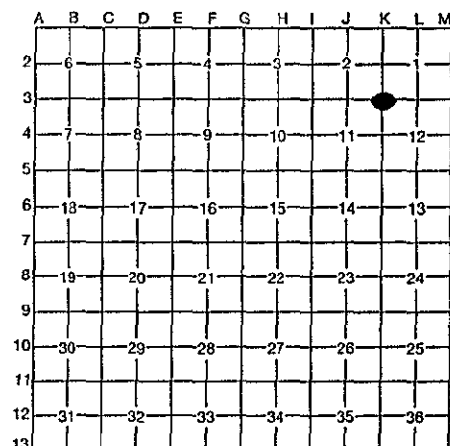

I, Kirk Breitels, in a field survey on Feb. 24, 19 95, do hereby certify that under requirements of P.A. 74, Michigan P.A. of 1970, the corner points mentioned in lines 1 and 2 above were in conformance with regulations and rules therefore as required in the current manual of survey instructions of the United States Department of the Interior, Bureau of Land Management or by a decree of a Court of Law and/or that the corner points mentioned in lines 3, 4 and 5 above were in conformance with the rules of the Michigan Board of Professional Surveyors or by a Decree of a Court of Law; established, re-established, monumented, re-monumented, recovered, found as expressed below:

NOTE: Not more than 4 corners, all in the same town and range, may be recorded on this certificate.

A. Description of original monument and accessories and/or subsequent restoration:

K-3	1838	GLO	Whitcomb	Set Post
		Kent Co. Wit.		Iron in pavement
	1974	LCRC #738	Bonnema	PK Nail
	1982	LCRC #3064	Jonker	Set Kent County Monument
	1990	LCRC #5407	Starr	Kent County Monument

The position of this corner was previously approved by the Kent County Remonumentation Peer Group, monumented by Robert J. Jonker on 8/18/82 and was recorded per LCRC #3064

B. Description of corner evidence found and/or method applied in restoring or reestablishing corner:

K-3 Found standard Kent Co. Mon. (Harrison) per witnesses from above LCRC as set by Robert J. Jonker in place of the 1 1/2" Iron over a 1" Solid Iron he found. Both Irons check with Kent Co. Wit. and LCRC #738.

LCRC #3064 & #5407

NW corner brick on house	S45°E	109.35'
Nail & KC Remon. tag SE side P. Pole	S40°W	46.58'
Nail & KC Remon. tag NW side Tele. Pole	N55°E	63.79'
SE corner block bldg.	N45°W	59.04'

C/L N-S bit. road is 1' E; On C/L bit. road E; C/L bit road W is 6' N.

P.A. 345 1990 KENT COUNTY
PEER APPROVED 6/22/95

CHAIRMAN *Harry Huber*

The selected location is accepted by me and is generally accepted by professional surveyors as the best available evidence of the position of the original corner.

C. Description of monument for corner and accessories established to perpetuate locating the position of the corner:

K-3 Standard Kent County Monument

NW corner brick on house	S45°E	109.41'
Nail & KC Remon. tag SE side P. Pole	S40°W	46.58'
Nail & KC Remon. tag NW side Tele. Pole	N55°E	63.70'
SE corner block bldg.	N45°W	59.08'

C/L N-S bit. road is 1' E; On C/L bit. road E; C/L bit road W is 6' N.



Signed by *Kirk Breitels*
Surveyor's Michigan License No. 30077

Date 6/22/95