

SURVEY & REMONUMENTATION

APR 28 1995

KENT COUNTY REMONUMENTATION

STATE OF MICHIGAN
COUNTY OF KENT
RECEIVED FOR RECORD

COMMISSION

LAND CORNER RECORDATION CERTIFICATE
Filing Requirement of Act 74, Mich. P.A. 1970

DEC 27 AM 9:04

For corners in
KENT COUNTY

(County)	Located In:	Corner Code #
1. Public Land Survey	T 8N R 12W	K-12
	T R	
	T R	
	T R	
2. Property Controlling in Section	S T R	
	S T R	
3. Miscellaneous Property in Sec.	S T R	
	S T R	

W. R. Byl
REG. OF DEEDS

7907

Register of Deeds Stamp & File Number

4. Lot No. _____, Recorded Plat _____
5. Private Claims _____

	A	B	C	D	E	F	G	H	I	J	K	L	M
2	6	5	4	3	2								
3													
4	7	8	9	10	11	12							
5													
6	18	17	16	15	14	13							
7													
8	19	20	21	22	23	24							
9													
10	30	29	28	27	26	25							
11													
12	31	32	33	34	35	36							
13													

I, William R. Byl, in a field survey on Oct. 19, 19 94, do hereby certify that under requirements of P.A. 74, Michigan P.A. of 1970, the corner points mentioned in lines 1 and 2 above were in conformance with regulations and rules therefore as required in the current manual of survey instructions of the United States Department of the Interior, Bureau of Land Management or by a decree of a Court of Law and/or that the corner points mentioned in lines 3, 4 and 5 above were in conformance with the rules of the Michigan Board of Land Surveyors or by a Decree of a Court of Law: established, re-established, monumented, re-monumented, recovered, found as expressed below:

NOTE: Not more than 4 corners, all in the same town and range, may be recorded on this certificate.

A. Description of original monument and accessories and/or subsequent restoration:

K-12	1838	GLO	Whitcomb	Set Post
		Kent Co. Wit.		Iron
	1981	LCRC #2351	Bonnema	Iron in mon. box
	1982	LCRC #3119	Merdzinski	Set Kent County Monument
	1990	LCRC #5416	Starr	Kent County Monument
	1992	LCRC #6635	McCloskey	Kent County Monument

P.A. 345 1990 KENT COUNTY
PEER APPROVED 12/22/94
CHAIRMAN *Harry Huber*

The position of this corner was previously approved by the Kent County Remonumentation Peer Group, monumented by John A. Merdzinski on 10/5/82 and was recorded per LCRC #3119.

B. Description of corner evidence found and/or method applied in restoring or reestablishing corner:


K-12 Found standard Kent Co. Mon. (Harrison) per witnesses from above LCRC as set by John A. Merdzinski in place of the 1/2" Copper Iron with copper cap in mon. box and "T" Iron in mon. box 2' below grade which he found. Both Irons and mon. boxes check with Kent Co. Wit. and LCRC #2351.

LCRC #3119		LCRC #5416 & 6635	
Nail & tag P. Pole	N25°E 99.75'	Nail & KC tag W. side P. Pole	N25°E 99.75'
Nail & tag top guard post	N45°E 6.77'	Nail & KC tag top guard rail post	N45°E 6.77'
Nail & tag top guard post	S25°E 9.53'	Nail & KC tag top guard rail post	S25°E 9.53'
Back of 30" conc. curb	W 1.23'	Back of 30" conc. curb & gutter	West 1.23'
PK C/L Alpine Ave.	W 33.65'	PK in C/L Alpine Ave.	West 33.65'

The selected location is accepted by me and is generally accepted by professional surveyors as the best available evidence of the position of the original corner.

C. Description of monument for corner and accessories established to perpetuate locating the position of the corner:

K-12 Standard Kent County Monument			
Nail & KC Remon. tag W. side P. Pole	N25°E	99.70'	
C/L top of fire hydrant	N90°E	31.26'	
C/L top of fire hydrant	S90°W	95.86'	
Set Nail & KC Remon. tag SE side P. Pole	S60°W	114.02'	
Set Nail & KC Remon. tag W. side P. Pole	S05°E	86.20'	
SW corner CB header	N35°W	108.54'	
Back of 30" conc. curb	N90°W	1.21'	

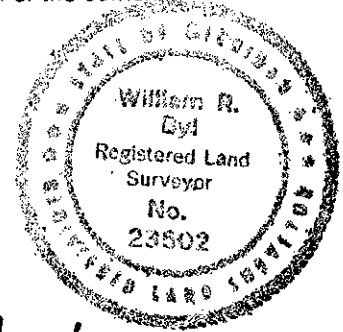

Signed by *W. R. Byl* Date 12/07/94
Surveyor's Michigan License No. 23502