

\$7.00
\$2.00

SEP 19 1985

KENT COUNTY REMONUMENTATION

LAND CORNER RECORDATION CERTIFICATE

Filing Requirement of Act 74, Mich. P.A. 1970

For corners in
KENT COUNTY
(County)

Located In:

Corner Code #

- | | | | | | |
|--------------------------------------|---|----|---|-----|-----|
| 1. Public Land Survey | T | 8N | R | 12W | L-3 |
| | T | | R | | |
| | T | | R | | |
| | T | | R | | |
| 2. Property Controlling in Section | S | | T | R | |
| | S | | T | R | |
| 3. Miscellaneous Property in Section | S | | T | R | |
| | S | | T | R | |


STATE OF MICHIGAN
COUNTY OF KENT
RECEIVED FOR RECORD

95 JUN 29 AM 11:57

REG. OF DEEDS
Lucy Standaert
8504

Register of Deeds Stamp & File Number

4. Lot No. _____, Recorded Plat _____
5. Private Claims _____

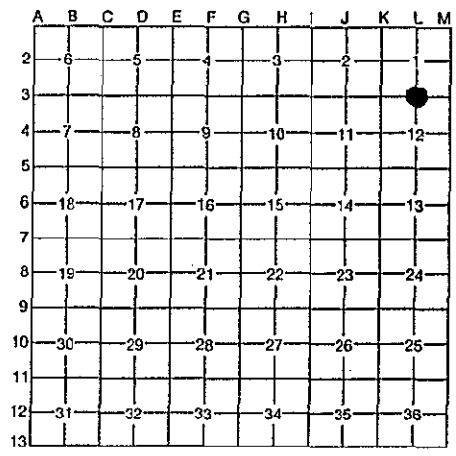

I, Kirk Breitels, in a field survey on Feb. 24, 19 95, do hereby certify that under requirements of P.A. 74, Michigan P.A. of 1970, the corner points mentioned in lines 1 and 2 above were in conformance with regulations and rules therefore as required in the current manual of survey instructions of the United States Department of the Interior, Bureau of Land Management or by a decree of a Court of Law and/or that the corner points mentioned in lines 3, 4 and 5 above were in conformance with the rules of the Michigan Board of Professional Surveyors or by a Decree of a Court of Law; established, re-established, monumented, re-monumented, recovered, found as expressed below:

NOTE: Not more than 4 corners, all in the same town and range, may be recorded on this certificate.

A. Description of original monument and accessories and/or subsequent restoration:

- | | | | | |
|-----|------|---------------|----------|--------------------------------------|
| L-3 | 1838 | GLO | Whitcomb | Set Post |
| | 1935 | Kent Co. Wit. | | Conc. Mon. |
| | 1973 | LCRC #523 | Spicer | 3/4" Iron in mon. box |
| | 1981 | LCRC #2568 | Bueche | Set Kent County Monument in mon. box |
| | 1990 | LCRC #5418 | Starr | Kent County Monument |

The position of this corner was previously approved by the Kent County Remonumentation Peer Group, monumented by John C. Bueche on 12/10/81 and was recorded per LCRC #2568.

B. Description of corner evidence found and/or method applied in restoring or reestablishing corner:

L-3 Found standard Kent Co. Mon. (Harrison) per witnesses from above LCRC as set by John C. Bueche in place of the 3/4" x 6" Iron on top of a conc. mon. he found. Both Iron and conc. mon. check with Kent Co. Wit. and LCRC #523.

LCRC #2568 & #5418

- | | | | |
|------------------------------|-----------|-------|---------|
| Nail & KC Remon. tag W. side | 28" Ash | N15°E | 124.06' |
| Nail & KC Remon. tag S. side | 14" Maple | N60°E | 85.05' |
| Nail & KC Remon. tag N. side | 24" Maple | S65°E | 72.55' |
| Nail & KC Remon. tag S. side | P. Pole | N45°W | 54.10' |
| Nail & KC Remon. tag SE side | P. Pole | S45°W | 65.50' |
- On C/L of blacktop road E-W-N-S

P.A. 345 1990 KENT COUNTY
PEER APPROVED 6/22/95
CHAIRMAN *Hansy Hubert*

The selected location is accepted by me and is generally accepted by professional surveyors as the best available evidence of the position of the original corner.

C. Description of monument for corner and accessories established to perpetuate locating the position of the corner:

- L-3 Standard Kent County Monument
- | | | | |
|----------------------------------|-----------|-------|---------|
| Nail & KC Remon. tag S. side | 24" Maple | N60°E | 85.16' |
| New Nail & KC Remon. tag N. side | 30" Maple | S65°E | 72.53' |
| Nail & KC Remon. tag S. side | P. Pole | N45°W | 54.10' |
| Nail & KC Remon. tag SE side | P. Pole | S45°W | 65.52' |
| Set Nail & KC Remon. tag W. side | 18" Maple | N30°E | 108.63' |
- On C/L of blacktop road E-W-N-S



Signed by *Kirk Breitels*
Surveyor's Michigan License No. 30077

Date 6/22/95