

**SURVEY & MONUMENTATION**

STATE OF MICHIGAN  
COUNTY OF KENT  
RECEIVED FOR RECORD

OCT 28 1994

**LAND CORNER RECORDATION CERTIFICATE**  
Filing Requirement of Act 74, Mich. P.A. 1970

94 AUG 24 AM 11:52

For corners in

COMMISSION

Kent (County)	Located In:	Alpine Twp. Corner Code #
1. Public Land Survey	T <u>8N</u> R <u>12W</u>	<u>L-4</u> <u>cen. sec. 12</u>
	T _____ R _____	_____
	T _____ R _____	_____
	T _____ R _____	_____
2. Property Controlling in Section	S _____ T _____ R _____	_____
	S _____ T _____ R _____	_____
3. Miscellaneous Property in Sec.	S _____ T _____ R _____	_____
	S _____ T _____ R _____	_____

*Lucy Bond*  
REG. OF DEEDS

6970

Register of Deeds Stamp & File Number

4. Lot No. \_\_\_\_\_, Recorded Plat \_\_\_\_\_  
5. Private Claims \_\_\_\_\_

	A	B	C	D	E	F	G	H	I	J	K	L	M
2	6	5	4	3	2	1							
3													
4	7	8	9	10	11								
5													
6	18	17	16	15	14	13							
7													
8	19	20	21	22	23	24							
9													
10	30	29	28	27	26	25							
11													
12	31	32	33	34	35	36							
13													

I, Wallace E. Glaza, in a field survey on August 12, 19 94, do hereby certify that under requirements of P.A. 74, Michigan P.A. of 1970, the corner points mentioned in lines 1 and 2 above were in conformance with regulations and rules therefore as required in the current manual of survey instructions of the United States Department of the Interior, Bureau of Land Management or by a decree of a Court of Law and/or that the corner points mentioned in lines 3, 4 and 5 above were in conformance with the rules of the Michigan Board of Land Surveyors or by a Decree of a Court of Law; established, re-established, monumented, re-monumented, recovered, found as expressed below:

**NOTE: Not more than 4 corners, all in the same town and range, may be recorded on this certificate.**

A. Description of original monument and accessories and/or subsequent restoration:

Williams & Works	L.C.R.C. No. 738 (Exxel)
1911 - Found old stake at corner of Section	Found 1/2" iron in mon. box
Replaced stake and put stones around it	Corner as held by County Surveyors since 19
1) 10" Apple East 15.3'	1) Nail in side T-pole East 13.72'
2) 6" Elm SE 25.2'	2) Nail in side T-pole NNW 45.22'
3) T-pole SW 49.5'	3) Nail in side 8" Elm SSE 33.61'
1944 - Found and accepted iron at corner	4) Centerline blacktop West 7'
1946 - Found and accepted iron at corner	
1949 - Found and accepted iron at center	
1957 - Found and accepted mon. box at center	

B. Description of corner evidence found and/or method applied in restoring or reestablishing corner:

L-4 (Center of Section 12, T8N, R12W, Alpine Township, Kent County, Michigan)  
Found rerod above I.P. in mon. box above stone pile. Existing location is 32.68' South and 8.81' East of the intersection of the 1/4 lines. Verified location ± with old angles and distances. Accepted location for center of Section. Replace rerod and I.P. with standard 4" x 30" Kent County Monument. (Harrison)

West 1/4 corner to center	-	2674.15'
North 1/4 corner to center	-	2673.08'
East 1/4 corner to center	-	2654.34'
South 1/4 corner to center	-	2622.21

P.A. 345 1990 KENT COUNTY.


PEER APPROVED 7/28/94

CHAIRMAN *Harry Huber*

C. Description of monument for corner and accessories established to perpetuate locating the position of the corner:

L-4 (4" x 30" Kent County Monument)

1) Remon tag & nail in E side P-pole	S10°W	239.36'
2) Remon tag & nail in S side P-pole	N65°W	45.13'
3) Remon tag & nail in E side P-pole	N10°W	274.55'
4) Remon tag & nail in NW side 4" Apple	N60°E	41.05'
5) Centerline North-South road	West	7' ±

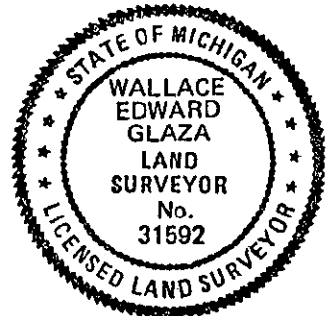

Signed by Wallace E. Glaza  
Glaza & Associates, Inc. 31592  
Surveyor's Michigan License No.

Date 8-16-94