$7.00 SEP 1 0 1995
$2.00

KENT COUNTY REMONUMENTATION

LAND CORNER RECORDATION CERTIFICATE

Filing Requirement of Act 74, Mich. P.A. 1970

STATE OF MICHIGAN
COUNTY OF KENT
RECEIVED FOR RECORD
95 JUN 29 AM 11:57
REG. OF DEEDS
8507

Register of Deeds Stamp & File Number

For corners in KENT COUNTY (County)

	Located In:	Corner Code #
1. Public Land Survey	T 8N R 12W	L-9
	T ___ R ___	
	T ___ R ___	
	T ___ R ___	
2. Property Controlling	S ___ T ___ R ___	
in Section	S ___ T ___ R ___	
3. Miscellaneous	S ___ T ___ R ___	
Property in Section	S ___ T ___ R ___	

4. Lot No. _____, Recorded Plat _____
5. Private Claims _____

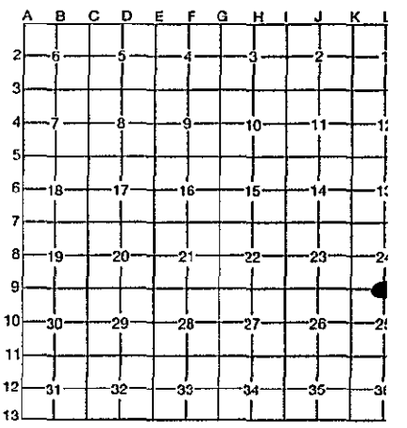

I, Kirk Breitels, in a field survey on May 10, 19 95, do hereby certify that under requirements of P.A. 74, Michigan P.A. of 1970, the corner points mentioned in lines 1 and 2 above were in conformance with regulations and rules therefore as required in the current manual of survey instructions of the United States Department of the Interior, Bureau of Land Management or by a decree of a Court of Law and/or that the corner points mentioned in lines 3, 4 and 5 above were in conformance with the rules of the Michigan Board of Professional Surveyors or by a Decree of a Court of Law; established, re-established, monumented, re-monumented, recovered, found as expressed below:

NOTE: Not more than 4 corners, all in the same town and range, may be recorded on this certificate.

A. Description of original monument and accessories and/or subsequent restoration:

L-9	1838	GLO	Whitcomb	Set Post
		Kent Co. Wit.		1" x 1 1/2" Iron Bar
	1973	LCRC #631	Spicer	1/2" Iron Bar in mon. box
	1981	LCRC #2570	Bueche	Set Kent County Monument in mon. box
	1990	LCRC #5421	Starr	Kent County Monument

The position of this corner was previously approved by the Kent County Remonumentation Peer Group, monumented by John C. Bueche on 12/10/81 and was recorded per LCRC #2570.

B. Description of corner evidence found and/or method applied in restoring or reestablishing corner:

L-9 Found standard Kent Co. Mon. (Harrison) per witnesses from above LCRC as set by John C. Bueche in place of the 3/4" x 18" Iron he found inside a mon. box. Said Iron checks with Kent Co. Wit. and LCRC #631.

LCRC #2570 & #5421

SW cor. brick hse. #393	N15°W	79.40'
SE cor. brick garage to hse #393	N30°E	93.25'
NW cor. hse. #392 foundation	S05°E	75.78'
NE cor. brick face garage hse. #406	S25°W	79.78'
Face of conc. curb	North	25.47'
C/L manhole	S60°W	15.2'
On C/L blktp. E-W		

P.A. 345 1990 KENT COUNTY
PEER APPROVED 6/22/95
CHAIRMAN Harry Huber

The selected location is accepted by me and is generally accepted by professional surveyors as the best available evidence of the position of the original corner.

C. Description of monument for corner and accessories established to perpetuate locating the position of the corner:

L-9 Standard Kent County Monument in mon. box

SW cor. brick hse. #393	N15°W	79.34'
SE cor. brick garage to hse #393	N30°E	93.14'
NW cor. hse. #392 foundation	S05°E	75.78'
NE cor. brick face garage hse. #406	S25°W	79.75'
Face of conc. curb	North	25.45'
C/L manhole	S60°W	15.25'
On C/L blktp. E-W		

STATE OF MICHIGAN
KIRK BREITELS
LAND SURVEYOR
NO 30077
LICENSED LAND SURVEYOR

Signed by Kirk Breitels Date 6/22/95

Surveyor's Michigan License No. 30077

FORM APPROVED BY MICHIGAN STATE BOARD OF PROFESSIONAL SURVEYORS, JAN. 28, 1971
REVISED MAY 14, 1975
REVISED JAN., 1983