

SURVEY & REMONUMENTATION

APR 28 1995

KENT COUNTY REMONUMENTATION

STATE OF MICHIGAN
COUNTY OF KENT
RECEIVED FOR RECORD

COMMISSION

LAND CORNER RECORDATION CERTIFICATE
Filing Requirement of Act 74, Mich. P.A. 1970

94 DEC 27 AM 9:05

For corners in
KENT COUNTY

(County)	Located In:	Corner Code #
1. Public Land Survey	T <u>8N</u> R <u>12W</u>	<u>L-13</u>
	T _____ R _____	_____
	T _____ R _____	_____
	T _____ R _____	_____
2. Property Controlling in Section	S _____ T _____ R _____	_____
	S _____ T _____ R _____	_____
3. Miscellaneous Property in Sec.	S _____ T _____ R _____	_____
	S _____ T _____ R _____	_____
4. Lot No. _____, Recorded Plat _____		
5. Private Claims _____		

W. R. Cyl
REG. OF DEEDS

7910

Register of Deeds Stamp & File Number

I, William R. Cyl, in a field survey on July 26, 19 94, do hereby certify that under requirements of P.A. 74, Michigan P.A. of 1970, the corner points mentioned in lines 1 and 2 above were in conformance with regulations and rules therefore as required in the current manual of survey instructions of the United States Department of the Interior, Bureau of Land Management or by a decree of a Court of Law and/or that the corner points mentioned in lines 3, 4 and 5 above were in conformance with the rules of the Michigan Board of Land Surveyors or by a Decree of a Court of Law; established, re-established, monumented, re-monumented, recovered, found as expressed below:

A	B	C	D	E	F	G	H	I	J	K	L	M
2	6	5	4	3	2	1						
3												
4	7	8	9	10	11	12						
5												
6	18	17	16	15	14	13						
7												
8	19	20	21	22	23	24						
9												
10	30	29	28	27	26	25						
11												
12	31	32	33	34	35	36						
13												

NOTE: Not more than 4 corners, all in the same town and range, may be recorded on this certificate.

A. Description of original monument and accessories and/or subsequent restoration:

L-13	1837	GLO	Brookfield	Set Post
		Kent Co. Wit.		Monument
	1980	LCRC #1317	VanLaar	Set Capped Iron
	1982	LCRC #3156	Hackbardt	Set Kent County Monument
	1990	LCRC #5423	Starr	Kent County Monument
	1992	LCRC #6640	McCloskey	Kent County Monument

P.A. 345 1990 KENT COUNTY
PEER APPROVED 12/22/94
CHAIRMAN *[Signature]*

The position of this corner was previously approved by the Kent County Remonumentation Peer Group, monumented by Glen S. Hackbardt on 8/4/82 and was recorded per LCRC #3156.

B. Description of corner evidence found and/or method applied in restoring or reestablishing corner:


L-13 Found standard Kent Co. Mon. (Harrison) per witnesses from above LCRC as set by Glen S. Hackbardt in place of a 10" Stone he found. Said Stone checks with Kent Co. Wit. and LCRC #1317.

<u>LCRC #3156</u>		<u>LCRC #5423 & #6640</u>	
Nail & tag 20" Poplar	N80°E 72.54'	same witnesses as LCRC #3156	
Nail & tag C.P.	N40°E 100.51'		
NE cor. brk. hse. #400	N10°W 81.51'		
SE cor. brick garage	West 60.70'		
N'y edge conc. dr.	South 4.62'		
3/4" Iron in pvmnt.	East 35.40'		

The selected location is accepted by me and is generally accepted by professional surveyors as the best available evidence of the position of the original corner.

C. Description of monument for corner and accessories established to perpetuate locating the position of the corner:

L-13 Standard Kent County Monument			
Nail & KC Remon. tag S. side 20" Poplar	N80°E	72.61'	
Nail & KC Remon. tag E. side P. Pole	N40°E	100.52'	
NE cor. brick house #400 Dakota	N10°W	81.51'	
SE cor. brick garage #400 Dakota	S90°W	60.70'	
N'y edge conc. dr.	S00°E	4.62'	
Kent Co. Mon. (L-1, T7N, R12W)	S90°E	35.40'	
Tree Row East			

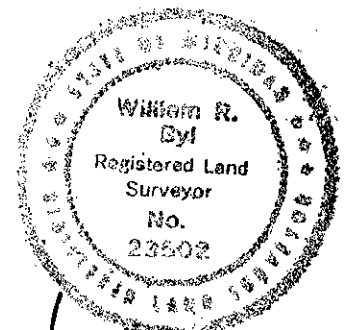

Signed by *[Signature]* Date 12/07/94
Surveyor's Michigan License No. 23502