

SURVEY &
REMONUMENTATION

MAY 22 2000

LAND CORNER RECORDATION CERTIFICATE
Filing Requirement of Act 74, Mich. P.A. 1970
KENT COUNTY REMONUMENTATION

For corners in

SECTION

Kent (County)	Located in: Oakfield Township	Corner Code #
1. Public Land Survey	T <u>9N</u> R <u>9W</u>	<u>A-3</u>
	T _____ R _____	_____
	T _____ R _____	_____
	T _____ R _____	_____
2. Property Controlling in Section	S _____ T _____ R _____	_____
	S _____ T _____ R _____	_____
3. Miscellaneous Property in Sec.	S _____ T _____ R _____	_____
	S _____ T _____ R _____	_____
4. Lot No. _____, Recorded Plat _____		
5. Private Claims _____		

STATE OF MICHIGAN
COUNTY OF KENT
RECEIVED FOR RECORD

1999 OCT 15 AM 8:08


REG. OF DEEDS

11392

Register of Deeds Stamp & File Number

I, Randy Kolehouse, in a field survey on February 4 19 99, do hereby certify that under requirements of P.A. 74 Michigan P.A. of 1970, the corner points mentioned in lines 1 and 2 above were in conformance with regulations and rules therefore as required in the current manual of survey instructions of the United States Department of the Interior, Bureau of Land Management or by a decree of a Court of Law and/or that the corner points mentioned in lines 3, 4 and 5 above were in conformance with the rules of the Michigan Board of Land Surveyors or by a Decree of a Court of Law, established, re-established, monumented, re-monumented, recovered, found as expressed below:

NOTE: Not more than 4 corners, all in the same town and range, may be recorded on this certificate.

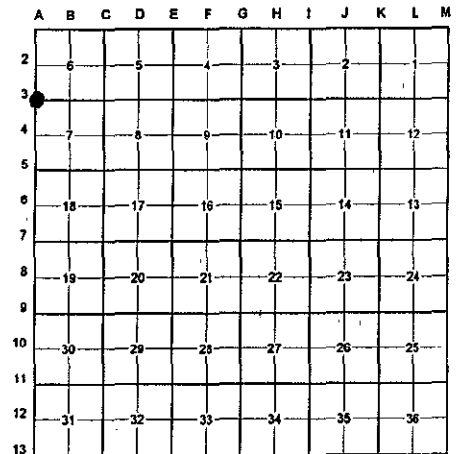

A. Description of original monument and accessories and/or subsequent restoration:

A-3	1837	G.L.O. Notes	Cathcart	Set Post
	1876&1880	Notes	Williams & Works	Stone
	1939	Witness Map	K.C. Surveyor	Concrete Monument
	1963	Notes	MSHD	Monument
	1985	L.C.R.C. #4304	R. Kolehouse	Fnd. "T" Iron / Set K.C. Monument (M-3, T9N, R10W)
	1991	L.C.R.C. #6220	C. Marschall	K.C. Monument (M-3, T9N, R10W)

P.A. 345 1990 KENT COUNTY
PEER APPROVED 7/29/99
CHAIRMAN Randy Kolehouse

Note: This corner is common with M-3, T9N, R10W.

This corner was originally approved by the Kent County Remonumentation Peer Group and monumented by Randy Kolehouse on 8/3/85 and was recorded per L.C.R.C. #4304.

B. Description of corner evidence found and/or method applied in restoring or reestablishing corner:

A-3 Found a Standard Kent County Monument 5.0' West of the C/L intersection of Ramsdell (gravel) running North and South and 15 Mile (gravel) running East per L.C.R.C.'s #4304 and #6220 as set by Randy Kolehouse in place of a "T" iron he found which checked the notes of MSHD and Williams & Works and the K.C. Surveyor's records.

L.C.R.C. #4304

L.C.R.C. #6220

Nail & K.C. Remon. tag in N. side 20" Oak S 75° E 84.27'
Nail & K.C. Remon. tag in S. side 16" Oak S 45° E 47.45'
Nail & K.C. Remon. tag in SE side 32" Oak S 30° W 34.00'
Nail & K.C. Remon. tag in SW side 36" Maple N 30° W 46.31'

Nail & Remon Tag in N sd. 12" Oak S 58 W 64.87' (m. 64.82')
Nail & Remon Tag in N sd. Oak 3' high (12") N 69 W 61.23' (m. 61.33')
Nail & Remon Tag in S sd. Pine (34") S 67 E 57.21' (m. 57.18')
Nail & Remon Tag in W sd. 14" Oak S 28 W 75.17' (m. 75.19')
Centerline x of 15 mile & ramsdell East 5'
Nail & Tag S sd. 42" Oak stump S 42 W 34.04' (m. 34.02')
Nail & Tag S sd. 22" Oak stump S 56 E 47.41' (m. 47.47')

The selected location is accepted by me and is generally accepted by professional surveyors as the best available evidence of the position of the original corner.

C. Description of monument for corner and accessories established to perpetuate locating the position of the corner:

A-3 Standard Kent County Monument

Nail & K.C. remon. tag on N side 14" Oak S 85° W 64.82'
Nail & K.C. remon. tag on N side 13" Oak N 69° W 61.33' (3' high)
Nail & K.C. remon. tag on W side 16" Oak S 28° W 75.19'
Nail & K.C. remon. tag on N side 34" Pine S 67° E 57.18'

Nail & K.C. remon. tag on S side 42" Oak stump S 42° W 34.02'
Nail & K.C. remon. tag on S side 22" Oak stump S 56° E 47.47'
C/L "X" of gravel roads running N-S-E, East 5.0'

Signed by Randy J. Kolehouse Date 9-27-99

WILLIAMS & WORKS

Surveyor's Michigan License No. 25854

