

**SURVEY &
REMONUMENTATION**

MAY 22 2000

LAND CORNER RECORDATION CERTIFICATE
Filing Requirement of Act 74, Mich. P.A. 1970
KENT COUNTY REMONUMENTATION

For corners in

<u>Kent</u> (County)	Located in: Oakfield Township	Corner Code # <u>A-8</u>
1. Public Land Survey	T <u>9N</u> R <u>9W</u>	<u>A-8</u>
	T _____ R _____	_____
	T _____ R _____	_____
	T _____ R _____	_____
2. Property Controlling In Section	S _____ T _____ R _____	_____
	S _____ T _____ R _____	_____
3. Miscellaneous Property in Sec.	S _____ T _____ R _____	_____
	S _____ T _____ R _____	_____

STATE OF MICHIGAN
COUNTY OF KENT
RECEIVED FOR RECORD
1999 OCT 15 AM 8:09
REG. OF DEEDS
[Signature]
11397
Register of Deeds Stamp & File Number


4. Lot No. _____, Recorded Plat _____
5. Private Claims _____

I, Randy Kolehouse, in a field survey on January 15, 19 99, do hereby certify that under requirements of P.A. 74 Michigan P.A. of 1970, the corner points mentioned in lines 1 and 2 above were in conformance with regulations and rules therefore as required in the current manual of survey instructions of the United States Department of the interior, Bureau of Land Management or by a decree of a Court of Law and/or that the corner points mentioned in lines 3, 4 and 5 above were in conformance with the rules of the Michigan Board of Land Surveyors or by a Decree of a Court of Law, established, re-established, monumented, re-monumented, recovered, found as expressed below:

NOTE: Not more than 4 corners, all in the same town and range, may be recorded on this certificate.

A. Description of original monument and accessories and/or subsequent restoration:

A-8	1837	G.L.O. Notes	Cathcart	Set Post
	1965	Witness Map	K.C. Surveyor	1" Iron
	1972	Records	Consumers Power Co.	1" Pipe
	1984	L.C.R.C. #3779A	William Byl	Fnd. 1" Iron Pipe / Set K.C. Monument
	1991	L.C.R.C. #6215	C. Marschall	K.C. Monument

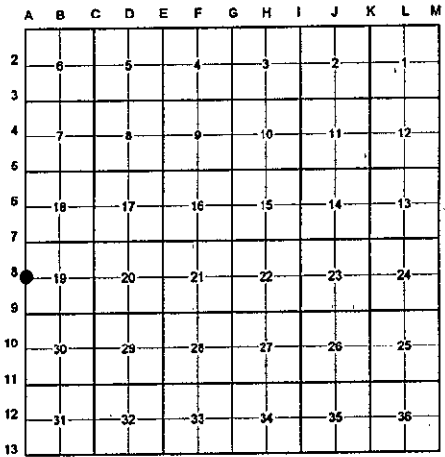

Note: This corner is common with M-8, T9N, R10W.

This corner was originally approved by the Kent County Remonumentation Peer Group and monumented by William Byl on 3/19/84 and was recorded per L.C.R.C. #3779A.

P.A. 345 1990 KENT COUNTY
PEER APPROVED 7/29/99
CHAIRMAN [Signature]

B. Description of corner evidence found and/or method applied in restoring or reestablishing corner:

A-8 Found a Standard Kent County Monument 1.5' West of the C/L intersection of Ramsdell Drive (bit.) running North and South and Peterson Road (bit.) running West per L.C.R.C.'s #3779A and #6215 as set by William Byl in place of a 1" iron pipe he found which checked the 1972 records of Consumers Power.

L.C.R.C. #3779A

SW cor. MBT pedestal (at slab grade) N 35 E 55.99'
"X" cut in top of curb N 50 W 36.86'
"X" cut in top of curb S 60 W 38.30'

L.C.R.C. #6215


SW cor. conc. MBT Pedestal (at slab grd) N 35 E 54.70' (m. 54.67')
Nail & Tag W sd. Twin 10" Oak S 12 E 116.89' (m. 116.71')
Nail & Tag S sd. P.P. S 65 W 174.11' (m. 174.15')
Nail & Tag E sd. P.P. S 60 E 148.01' (m. 148.03')

The selected location is accepted by me and is generally accepted by professional surveyors as the best available evidence of the position of the original corner.

C. Description of monument for corner and accessories established to perpetuate locating the position of the corner:

A-8 Standard Kent County Monument

SW cor. conc. MBT pedestal (at slab grade) N 35° E 54.67'
Nail & K.C. remon. tag on S side P. pole S 65° W 174.15'
Nail & K.C. remon. tag on W side P. pole S 20° W 75.18'
Nail & K.C. remon. tag on W side 12" Oak S 12° E 116.71'
Nail & K.C. remon. tag on E side P. pole S 60° E 148.03'
On C/L of bit. road running W
C/L of bit. road running N-S, East 1.5'

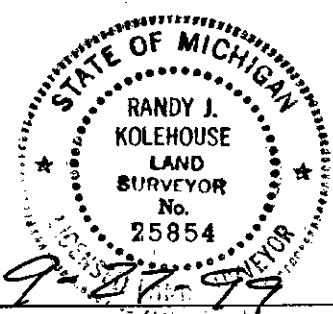

Signed by Randy J. Kolehouse Date 9-27-99
WILLIAMS & WORKS

Surveyor's Michigan License No. 25854