

SURVEY & REMONUMENTATION

**\$7.00**  
**\$2.00**

MAY 22 2000

**SECTION LAND CORNER RECORDATION CERTIFICATE**  
Filing Requirement of Act 74, Mich. P.A. 1970  
KENT COUNTY REMONUMENTATION

For corners in

<u>Kent</u> (County)	Located in: <u>Oakfield</u> Township	Corner Code #	
1. Public Land Survey	T <u>9N</u> R <u>9W</u>	<u>B-2</u>	
	T _____ R _____	_____	_____
	T _____ R _____	_____	_____
	T _____ R _____	_____	_____
2. Property Controlling in Section	S _____ T _____ R _____	_____	_____
	S _____ T _____ R _____	_____	_____
3. Miscellaneous Property in Sec.	S _____ T _____ R _____	_____	_____
	S _____ T _____ R _____	_____	_____

REG. OF DEEDS


*[Signature]*

STATE OF MICHIGAN  
COUNTY OF KENT  
RECEIVED FOR RECORD  
1999 DEC 27 AM 8:18

**11629**

Register of Deeds Stamp & File Number

4. Lot No. \_\_\_\_\_, Recorded Plat \_\_\_\_\_  
5. Private Claims \_\_\_\_\_

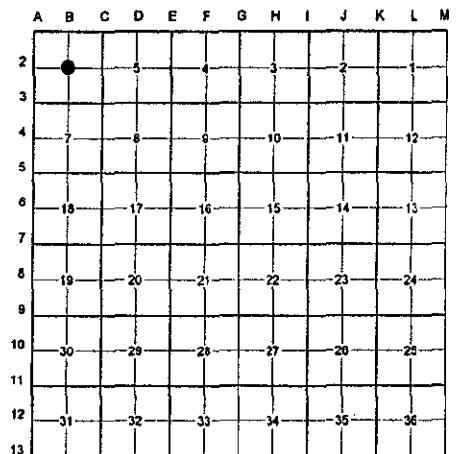

I, Randy Kolehouse, in a field survey on December 16 19 99, do hereby certify that under requirements of P.A. 74 Michigan P.A. of 1970, the corner points mentioned in lines 1 and 2 above were in conformance with regulations and rules therefore as required in the current manual of survey instructions of the United States Department of the interior, Bureau of Land Management or by a decree of a Court of Law and/or that the corner points mentioned in lines 3, 4 and 5 above were in conformance with the rules of the Michigan Board of Land Surveyors or by a Decree of a Court of Law; established, re-established, monumented, re-monumented, recovered, found as expressed below:

**NOTE: Not more than 4 corners, all in the same town and range, may be recorded on this certificate.**

A. Description of original monument and accessories and/or subsequent restoration:

B-2 This corner was not originally set by the G.L.O.  
N/A Survey Records M. Rosema Set Iron at Intersection of 1/4 Lines

P.A. 345 1990 KENT COUNTY  
PEER APPROVED 12/2/99  
CHAIRMAN [Signature]

B. Description of corner evidence found and/or method applied in restoring or reestablishing corner:


B-2 Found a capped true line iron as set by M. Rosema at the intersection of 1/4 lines on the C/L of a tree row running South, on line of the remains of a fence running North and South, and the remains of a fence running East. The found iron is 0.1' West and 0.1' South of intersection of 1/4 lines. Held iron as Center of Section.

The selected location is accepted by me and is generally accepted by professional surveyors as the best available evidence of the position of the original corner.

C. Description of monument for corner and accessories established to perpetuate locating the position of the corner:

B-2 Replaced Capped Iron with a Standard Kent County Monument

- Nail & K.C. remon. tag on S side 10" Oak N 85° W 14.78'
- Nail & K.C. remon. tag on SW side 10" Oak N 45° W 20.71'
- Nail & K.C. remon. tag on E side 15" Oak N 05° E 23.10'
- Nail & K.C. remon. tag on S side 12" Oak N 70° E 22.84'
- Nail & K.C. remon. tag on W side 10" Oak S 05° W 9.63'
- On a tree row running S
- On remains of fence line running N-S
- On remains of fence line running E

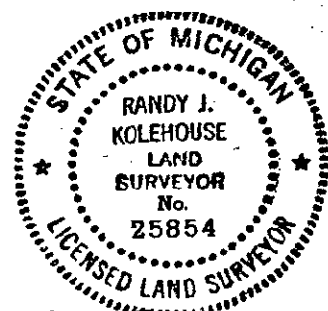

Signed by Randy J. Kolehouse  
WILLIAMS & WORKS

Date 12-20-99

Surveyor's Michigan License No. 25854