

MAY 28 2000

SECTION

LAND CORNER RECORDATION CERTIFICATE
Filing Requirement of Act 74, Mich. P.A. 1970
KENT COUNTY REMONUMENTATION

For corners in

Kent (County)	Located in:	Oakfield Township	Corner Code #
1. Public Land Survey	T <u>9N</u>	R <u>9W</u>	<u>B-3</u>
	T _____	R _____	_____
	T _____	R _____	_____
	T _____	R _____	_____
2. Property Controlling in Section	S _____	T _____	R _____
	S _____	T _____	R _____
3. Miscellaneous Property in Sec.	S _____	T _____	R _____
	S _____	T _____	R _____

REG. OF DEEDS


[Signature]

STATE OF MICHIGAN
COUNTY OF KENT
RECEIVED FOR RECORD
1999 OCT 27 AM 8:35

11402

Register of Deeds Stamp & File Number

4. Lot No. _____, Recorded Plat _____
5. Private Claims _____

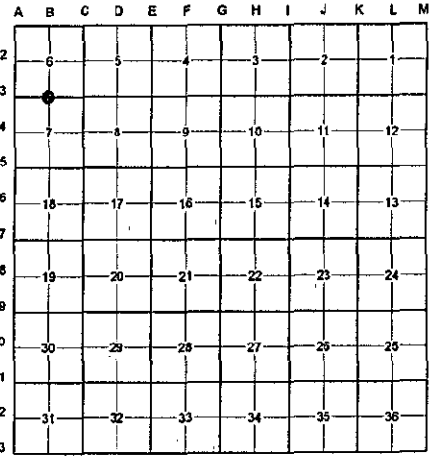

I, Randy Kolehouse, in a field survey on March 22 19 99, do hereby certify that under requirements of P.A. 74 Michigan P.A. of 1970, the corner points mentioned in lines 1 and 2 above were in conformance with regulations and rules therefore as required in the current manual of survey instructions of the United States Department of the Interior, Bureau of Land Management or by a decree of a Court of Law and/or that the corner points mentioned in lines 3, 4 and 5 above were in conformance with the rules of the Michigan Board of Land Surveyors or by a Decree of a Court of Law; established, re-established, monumented, re-monumented, recovered, found as expressed below:

NOTE: Not more than 4 corners, all in the same town and range, may be recorded on this certificate.

A. Description of original monument and accessories and/or subsequent restoration:

B-3	1837	G.L.O. Notes	Cathcart	Set Post
	1940	Witness Map	K.C. Surveyor	Concrete Monument
	1981	L.C.R.C. #2078	Nederveld & Jonker	Iron
	1982	L.C.R.C. #2876	Jonker Land Surveys	Fnd. Solid Iron Bar Over Conc. Mon. / Set K.C. Monument
	1989	L.C.R.C. #5171	John C. Bueche	K.C. Monument
	1997	L.C.R.C. #9630	Kirk Breitels	K.C. Monument

This corner was originally approved by the Kent County Remonumentation Peer Group and monumented by Rob Jonker on 5/19/82 and was recorded per L.C.R.C. #2876.

B. Description of corner evidence found and/or method applied in restoring or reestablishing corner:

B-3 Found a Standard Kent County Monument on the C/L of 15 Mile road (gravel) running East and West, on line of an old tree row running South, per L.C.R.C.'s #2876, #5171 and #9630 as set by Rob Jonker in place of a 1"x10" solid iron bar (bent) he found over the top of a 4" concrete monument which checked L.C.R.C. #2078 and the K.C. Surveyor's records.

L.C.R.C. #2876

L.C.R.C. #9630

Remon. tag on E side 14" tr. Oak S05°W 29.89'	Nail & KC Remon. tag E. side 20" Tr. Oak S05°W 29.80' (m. 29.79')
Remon. tag on NW side 4" Oak S50°W 82.82'	Nail & KC Remon. tag NW side 12" Oak S50°W 82.88' (m. 82.85')
Remon. tag on E side 6" Tw.Box Elder N25°W 24.78'	Nail & KC Remon. Tag E. side 10" Tw. Box Elder N25°W 24.78'
Remon. tag on S side 8" Quad Box Elder N65°W 59.66'	Nail & KC Remon. tag S. side 12" Quad Box Elder N65°W 59.47' (m. 59.46')
Remon. tag on S side 6" Walnut N80°E 140.08'	Nail & KC Remon. tag S. side 14" Walnut N80°E 139.98' (m. 139.93')

The selected location is accepted by me and is generally accepted by professional surveyors as the best available evidence of the position of the original corner.

C. Description of monument for corner and accessories established to perpetuate locating the position of the corner:


B-3 Standard Kent County Monument

- Nail & K.C. remon. tag on E side 20" triple Oak S 05° W 29.79'
- Nail & K.C. remon. tag on NW side 12" Oak S 50° W 82.85'
- Nail & K.C. remon. tag on E side twin 10" Box Elder N 25° W 24.78'
- Nail & K.C. remon. tag on S side 12" quad Box Elder N 65° W 59.46'
- Nail & K.C. remon. tag on S side 14" Walnut N 80° E 139.93'
- On C/L of gravel road running E-W
- On old tree row running S

P.A. 345 1990 KENT COUNTY

PEER APPROVED 7/29/99

CHAIRMAN [Signature]

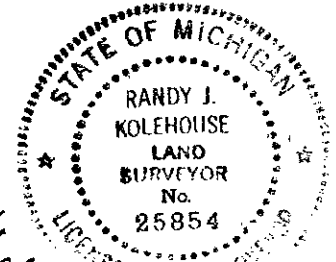

Signed by Randy J. Kolehouse
WILLIAMS & WORKS

Date 10-11-99

Surveyor's Michigan License No. 25854