

MAY 22 2000

SECTION

LAND CORNER RECORDATION CERTIFICATE
Filing Requirement of Act 74, Mich. P.A. 1970
KENT COUNTY REMONUMENTATION

For corners in

Kent
(County)

Located in: Oakfield
Township

Corner Code #

1. Public Land Survey	T <u>9N</u>	R <u>9W</u>	<u>B-5</u>
	T _____	R _____	_____
	T _____	R _____	_____
	T _____	R _____	_____
2. Property Controlling in Section	S _____	T _____	R _____
	S _____	T _____	R _____
3. Miscellaneous Property in Sec.	S _____	T _____	R _____
	S _____	T _____	R _____

REG. OF DEEDS

[Signature]

STATE OF MICHIGAN
COUNTY OF KENT
RECEIVED FOR RECORD
1999 OCT 27 AM 8:35

11403

Register of Deeds Stamp & File Number

4. Lot No. _____, Recorded Plat _____


5. Private Claims _____

I, Randy Kolehouse, in a field survey on April 26 19 99, do hereby certify that under requirements of P.A. 74 Michigan P.A. of 1970, the corner points mentioned in lines 1 and 2 above were in conformance with regulations and rules therefore as required in the current manual of survey instructions of the United States Department of the Interior, Bureau of Land Management or by a decree of a Court of Law and/or that the corner points mentioned in lines 3, 4 and 5 above were in conformance with the rules of the Michigan Board of Land Surveyors or by a Decree of a Court of Law; established, re-established, monumented, re-monumented, recovered, found as expressed below:

NOTE: Not more than 4 corners, all in the same town and range, may be recorded on this certificate.

A. Description of original monument and accessories and/or subsequent restoration:

B-5	1837	G.L.O. Notes	Cathcart	Set Post
	1980	L.C.R.C. #1623	Glaza & Associates	PK Nail
	1982	L.C.R.C. #2875	Jonker Land Surveys	Fnd. PK Nail / Set K.C. Monument
	1989	L.C.R.C. #5172	John Bueche	K.C. Monument
	1997	L.C.R.C. #9631	Keith Breitels	K.C. Monument

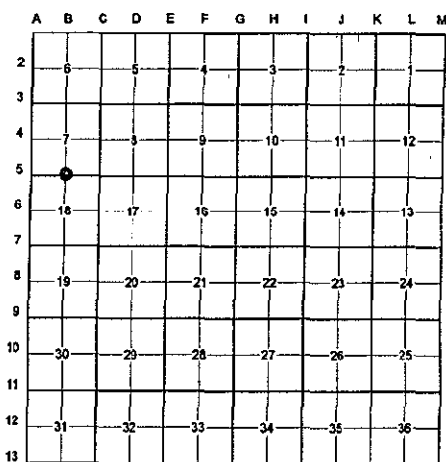

This corner was originally approved by the Kent County Remonumentation Peer Group and monumented by Rob Jonker on 5/24/82 and was recorded per L.C.R.C. #2875.

B. Description of corner evidence found and/or method applied in restoring or reestablishing corner:

B-5 Found a Standard Kent County Monument 6' North of the C/L of 14 Mile Road (bit.) running East and West, per L.C.R.C.'s #2875, #5172, and #9631 as set by Rob Jonker in place of a PK nail he found which checked L.C.R.C. #1623 and the K.C. Surveyor's records.

L.C.R.C. #2875

L.C.R.C. #9631

Remon. Tag on NW side 48" Maple N35°E 89.8'
SE cor. Hse. Fnd. N15°W 84.03'
Chiseled "X" on E end conc. Culvert N10°E 30.19'
C/L E-W pavement is South 6.5'm/
On line old tree line to South

Nail & KC Remon. Tag NW side 52" Maple N35°E 89.75' (m. 89.74)
Nail & KC Remon. Tag SW side 48" Maple N50°W 92.95' (m. 92.93)
Nail & KC Remon. Tag W. side 24" Maple S05°W 80.12' (m. 80.10)
SE corner hse. Fnd. N15°W 84.03' (m. 84.05)
Chiseled "X" on E. end conc. Culv. N10°E 30.19' (m. 30.20)
C/L E-W pavement is South 6.5'+/-
On line old stump line to South

The selected location is accepted by me and is generally accepted by professional surveyors as the best available evidence of the position of the original corner.

C. Description of monument for corner and accessories established to perpetuate locating the position of the corner:


B-5 Standard Kent County Monument

Nail & K.C. remon. tag on NW side 52" Maple N 35° E 89.74'
Nail & K.C. remon. tag on SW side 48" Maple N 50° W 92.93'
Nail & K.C. remon. tag on W side 28" Maple S 05° W 80.10'
SE cor. hse. (fndn.) N 15° W 84.05'
Chiseled "X" on E end onc. Culvert N 10° E 30.20'
C/L of bit. road running E-W, South 6'

P.A. 345 1990 KENT COUNTY

PEER APPROVED 7/29/99

CHAIRMAN [Signature]

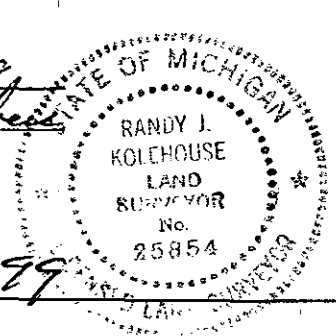

Signed by Randy J. Kolehouse

Date 10-11-99

WILLIAMS & WORKS

Surveyor's Michigan License No. 25854