

MAY 22 2000

SECTION

LAND CORNER RECORDATION CERTIFICATE
Filing Requirement of Act 74, Mich. P.A. 1970
KENT COUNTY REMONUMENTATION

For corners in

Kent (County)	Located in: Oakfield Township	Corner Code #
1. Public Land Survey	T <u>9N</u> R <u>9W</u>	<u>B-7</u>
	T _____ R _____	_____
	T _____ R _____	_____
	T _____ R _____	_____
2. Property Controlling in Section	S _____ T _____ R _____	_____
	S _____ T _____ R _____	_____
3. Miscellaneous Property in Sec.	S _____ T _____ R _____	_____
	S _____ T _____ R _____	_____

REG. OF DEEDS

[Handwritten Signature]

STATE OF MICHIGAN
COUNTY OF KENT
RECEIVED FOR RECORD
1999 OCT 27 AM 8:35

11404

Register of Deeds Stamp & File Number


4. Lot No. _____, Recorded Plat _____
5. Private Claims _____

I, Randy Kolehouse, in a field survey on March 12 19 99, do hereby certify that under requirements of P.A. 74 Michigan P.A. of 1970, the corner points mentioned in lines 1 and 2 above were in conformance with regulations and rules therefore as required in the current manual of survey instructions of the United States Department of the Interior, Bureau of Land Management or by a decree of a Court of Law and/or that the corner points mentioned in lines 3, 4 and 5 above were in conformance with the rules of the Michigan Board of Land Surveyors or by a Decree of a Court of Law; established, re-established, monumented, re-monumented, recovered, found as expressed below:

NOTE: Not more than 4 corners, all in the same town and range, may be recorded on this certificate.

A. Description of original monument and accessories and/or subsequent restoration:

B-7	1837	G.L.O. Notes	Cathcart	Set Post
	1991	L.C.R.C. #5745	Thomas Chettleburgh	Fnd. Iron Bar / Set K.C. Monument
	1997	L.C.R.C. #9632	Kirk Breitels	K.C. Monument

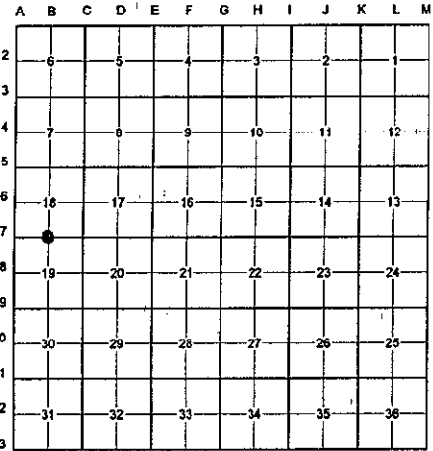

This corner was originally approved by the Kent County Remonumentation Peer Group and monumented by Thomas Chettleburgh on 2/7/91 and was recorded per L.C.R.C. #5745.

B. Description of corner evidence found and/or method applied in restoring or reestablishing corner:

B-7 Found a Standard Kent County Monument on the C/L of Harvard Avenue (gravel) running East, extended West and 19' ± West of the C/L of Harvard Avenue extended South per L.C.R.C.'s #5745 and #9632 as set by Thomas Chettleburgh in place of an iron bar.

L.C.R.C. #5745

L.C.R.C. #9632

- KC Remon tag in NW side of 17" Oak N50° E 52.12'
- KC Remon tag in N. side of 36" Maple S88°E 25.45'
- KC Remon tag in E. side of 14" Maple S09°E 16.04'
- KC Remon tag in NW side of 13" Ash S45°W 6.39'
- KC Remon tag in N. side of 17" Maple S89°W 33.38'
- KC Remon tag in NE side of 17" Maple N24°W 44.81'

- Nail & KC Remon. tag NW side Tw. 20" Oak N50°E 52.12'
- Nail & KC Remon. tag N. side 38" Maple S88°E 25.45' (m. 25.44')
- Nail & KC Remon. tag E. side 18" Maple S09°E 16.09' (m. 16.11')
- Nail & KC Remon. tag NW side 16" Ash S45°W 6.36'
- Nail & KC Remon. tag N. side 20" Maple S89°W 33.38' (m. 33.39')
- Nail & KKC Remon. tag NE side 20" Maple N24°W 44.81' (m. 44.80')
- Mon. @ S. side small ditch E-W

The selected location is accepted by me and is generally accepted by professional surveyors as the best available evidence of the position of the original corner.

C. Description of monument for corner and accessories established to perpetuate locating the position of the corner:


B-7 Standard Kent County Monument

- Nail & K.C. remon. tag on NW side twin 20" Oak N 50° E 52.12'
- Nail & K.C. remon. tag on N side 38" Maple S88° E 25.44'
- Nail & K.C. remon. tag on E side 18" Maple S 09° E 16.11'
- Nail & K.C. remon. tag on NW side 16" Ash S 45° W 6.36'
- Nail & K.C. remon. tag on N side 20" Maple S 89° W 33.39'
- Nail & K.C. remon. tag on NE side 20" Maple N 24° W 44.80'

P.A. 345 1990 KENT COUNTY

PEER APPROVED 7/29/99

CHAIRMAN *[Handwritten Signature]*

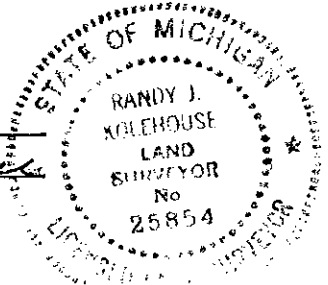

Signed by *Randy J. Kolehouse*
WILLIAMS & WORKS

Date 10-11-99

Surveyor's Michigan License No. 25854