

**SURVEY &
REMONUMENTATION**

MAY 22 2000

SECTION LAND CORNER RECORDATION CERTIFICATE
Filing Requirement of Act 74, Mich. P.A. 1970
KENT COUNTY REMONUMENTATION

For corners in

Kent (County)	Located in: Oakfield Township	Corner Code #
1. Public Land Survey	T <u>9N</u> R <u>9W</u>	<u>B-11</u>
	T _____ R _____	_____
	T _____ R _____	_____
	T _____ R _____	_____
2. Property Controlling in Section	S _____ T _____ R _____	_____
	S _____ T _____ R _____	_____
3. Miscellaneous Property in Sec.	S _____ T _____ R _____	_____
	S _____ T _____ R _____	_____

REG. OF DEEDS

[Handwritten Signature]

STATE OF MICHIGAN
COUNTY OF KENT
RECEIVED FOR RECORD
1999 OCT 27 AM 8:35

11406

Register of Deeds Stamp & File Number

4. Lot No. _____, Recorded Plat _____
5. Private Claims _____

I, Randy Kolehouse, in a field survey on March 17 19 99, do hereby certify that under requirements of P.A. 74 Michigan P.A. of 1970, the corner points mentioned in lines 1 and 2 above were in conformance with regulations and rules therefore as required in the current manual of survey instructions of the United States Department of the Interior, Bureau of Land Management or by a decree of a Court of Law and/or that the corner points mentioned in lines 3, 4 and 5 above were in conformance with the rules of the Michigan Board of Land Surveyors or by a Decree of a Court of Law; established, re-established, monumented, re-monumented, recovered, found as expressed below:

NOTE: Not more than 4 corners, all in the same town and range, may be recorded on this certificate.

A. Description of original monument and accessories and/or subsequent restoration:

B-11	1837	G.L.O. Notes	Cathcart	Set Post
	1978	L.C.R.C. #1205	Nederveld & Jonker	"L" Iron
	1981	L.C.R.C. #1674	Williams & Works	Fnd Angle Iron / Set K.C. Monument
	1989	L.C.R.C. #5174	John C. Bueche	K.C. Monument
	1997	L.C.R.C. #9635	Kirk Breitels	K.C. Monument

P.A. 345 1990 KENT COUNTY
PEER APPROVED 7/29/99
CHAIRMAN [Signature]

This corner was originally approved by the Kent County Remonumentation Peer Group and monumented by Williams & Works on 4/15/81 and was recorded per L.C.R.C. #1674.

B. Description of corner evidence found and/or method applied in restoring or reestablishing corner:

B-11 Found a Standard Kent County Monument on the C/L of 11 Mile Road (gravel) running East and West, on field line to North, per L.C.R.C.'s #1674, #5174, and #9635 as set by Williams & Works in place of an angle iron they found which checked L.C.R.C. #1205.

L.C.R.C. #1674

L.C.R.C. #9635

K.C. Remon. tag and nail in N. side 40" Oak N.80°W. 236.83'
K.C. Remon. tag and nail in S. side 44" Oak S.85°W. 210.31'
K.C. Remon. tag and nail in S. side 48" Aspen N.75°E. 103.00'
K.C. Remon. tag and nail in W. side Power Pole North 56.13'
K.C. Remon. tag and nail in NE. side Power Pole S.65°E. 237.15'
On center line 11 mile Rd. (gravel) E & W


Nail & KC Remon. tag N. side 48" Oak N80°W 236.86' (m. 236.80')
Nail & KC Remon. tag S. side 56" Oak S85°W 210.34' (m. 210.29')
Nail & KC Remon. tag S. side 56" Aspen N75°E 102.98' (m. 102.95')
Nail & KC Remon. tag W. side Power Pole North 56.10' (m. 56.06')
Nail & KC Remon. tag NE side Power Pole S65°E 237.08' (m. 237.01')
On centerline 11 Mile Road (gravel) E-W

The selected location is accepted by me and is generally accepted by professional surveyors as the best available evidence of the position of the original corner.

C. Description of monument for corner and accessories established to perpetuate locating the position of the corner:

B-11 Standard Kent County Monument

Nail & K.C. remon. tag on N side 48" Oak N 80° W 236.80'
Nail & K.C. remon. tag on S side 56" Oak S 85° W 210.29'
Nail & K.C. remon. tag on S side 56" Aspen N 75° E 102.95'
Nail & K.C. remon. tag on W side P. pole North 56.06'
Nail & K.C. remon. tag on NE side P. pole S 65° E 237.01'
On C/L of gravel road running E-W
On field line running N

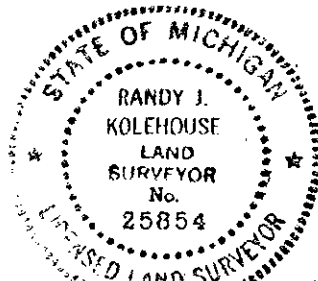

Signed by Randy J. Kolehouse Date 10-11-99

WILLIAMS & WORKS

Surveyor's Michigan License No. 25854