

SURVEY &  
REMONUMENTATION

\$7.00  
\$2.00

MAY 22 2000

LAND CORNER RECORDATION CERTIFICATE  
Filing Requirement of Act 74, Mich. P.A. 1970  
KENT COUNTY REMONUMENTATION

For corners in SECTION  
Kent  
(County)

Located in: Oakfield Township Corner Code #

1. Public Land Survey	T <u>9N</u>	R <u>9W</u>	<u>B-12</u>
	T _____	R _____	_____
	T _____	R _____	_____
	T _____	R _____	_____
2. Property Controlling in Section	S _____	T _____	R _____
	S _____	T _____	R _____
3. Miscellaneous Property in Sec.	S _____	T _____	R _____
	S _____	T _____	R _____

STATE OF MICHIGAN  
COUNTY OF KENT  
RECEIVED FOR RECORD  
1999 DEC 30 AM 9:20  
REG. OF DEEDS  
*[Signature]*  
11682  
Register of Deeds Stamp & File Number

4. Lot No. \_\_\_\_\_, Recorded Plat \_\_\_\_\_  
5. Private Claims \_\_\_\_\_

I, Randy Kolehouse, in a field survey on December 16 19 99, do hereby certify that under requirements of P.A. 74 Michigan P.A. of 1970, the corner points mentioned in lines 1 and 2 above were in conformance with regulations and rules therefore as required in the current manual of survey instructions of the United States Department of the Interior, Bureau of Land Management or by a decree of a Court of Law and/or that the corner points mentioned in lines 3, 4 and 5 above were in conformance with the rules of the Michigan Board of Land Surveyors or by a Decree of a Court of Law; established, re-established, monumented, re-monumented, recovered, found as expressed below:

NOTE: Not more than 4 corners, all in the same town and range, may be recorded on this certificate.

A. Description of original monument and accessories and/or subsequent restoration:

B-12 This corner was not originally set by the G.L.O.  
1848 Survey Records Caulkins

Found no other information on record.

P.A. 345 1990 KENT COUNTY,  
PEER APPROVED 6/24/99  
CHAIRMAN *[Signature]*

B. Description of corner evidence found and/or method applied in restoring or reestablishing corner:


B-12 Found a capped rebar #31592/40166 (Glaza) at the intersection of 1/4 lines which checks Caulkins' survey from 1848 by 2' ± East and West and 2' North and South. Found no occupation as point falls in woods. Accepted capped rebar as Center of Section.

The selected location is accepted by me and is generally accepted by professional surveyors as the best available evidence of the position of the original corner.

C. Description of monument for corner and accessories established to perpetuate locating the position of the corner:

B-12 Replaced Capped Rebar with a Standard Kent County Monument

- Nail & K.C. remon. tag on E side 12" Tri. Oak N 20° E 23.93'
- Nail & K.C. remon. tag on S side 28" Oak S 55° E 16.45'
- Nail & K.C. remon. tag on E side 28" Oak S 10° W 31.31'
- Nail & K.C. remon. tag on S side 28" Oak N 65° W 51.15'
- Nail & K.C. remon. tag on SW side 24" Oak N 20° W 34.49'

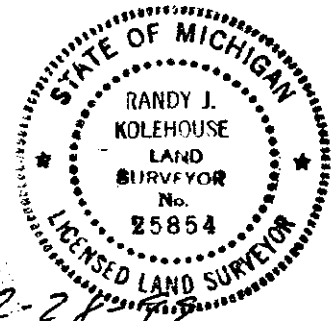

Signed by *[Signature]*  
WILLIAMS & WORKS

Date 12-28-99

Surveyor's Michigan License No. 25854

