

SURVEY &
REMONUMENTATION

\$7.00
\$2.00

MAY 22 2000

SECTION


LAND CORNER RECORDATION CERTIFICATE
Filing Requirement of Act 74, Mich. P.A. 1970
KENT COUNTY REMONUMENTATION

For corners in

| Kent (County) | Located in: Oakfield Township | Corner Code # |
|---------------------------------------|----------------------------------|---------------|
| 1. Public Land Survey | T <u>9N</u> R <u>9W</u> | <u>C-2</u> |
| | T _____ R _____ | _____ |
| | T _____ R _____ | _____ |
| | T _____ R _____ | _____ |
| 2. Property Controlling in Section | S _____ T _____ R _____ | _____ |
| | S _____ T _____ R _____ | _____ |
| 3. Miscellaneous Property in Sec. | S _____ T _____ R _____ | _____ |
| | S _____ T _____ R _____ | _____ |

STATE OF MICHIGAN
COUNTY OF KENT
RECEIVED FOR RECORD
1999 DEC 30 AM 9:20
REG. OF DEEDS
[Signature]
11683
Register of Deeds Stamp & File Number

4. Lot No. _____, Recorded Plat _____
5. Private Claims _____

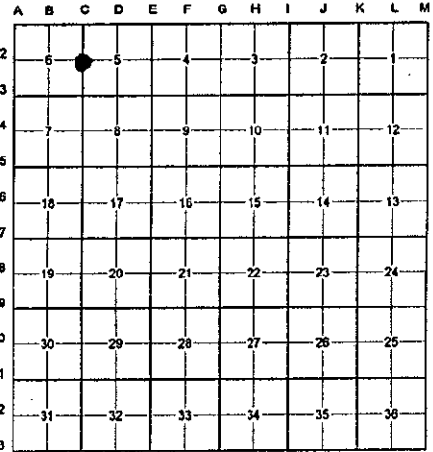

I, Randy Kolehouse, in a field survey on October 25 19 99, do hereby certify that under requirements of P.A. 74 Michigan P.A. of 1970, the corner points mentioned in lines 1 and 2 above were in conformance with regulations and rules therefore as required in the current manual of survey instructions of the United States Department of the Interior, Bureau of Land Management or by a decree of a Court of Law and/or that the corner points mentioned in lines 3, 4 and 5 above were in conformance with the rules of the Michigan Board of Land Surveyors or by a Decree of a Court of Law; established, re-established, monumented, re-monumented, recovered, found as expressed below:

NOTE: Not more than 4 corners, all in the same town and range, may be recorded on this certificate.

A. Description of original monument and accessories and/or subsequent restoration:

| C-2 | 1837 | G.L.O. Notes | Cathcart | Set Post |
|-----|------|----------------|--------------------|--------------------------------|
| | 1983 | L.C.R.C. #3326 | Glaza & Associates | 1/2" Rerod |
| | 1984 | L.C.R.C. #3729 | Williams & Works | Fnd. Rerod / Set K.C. Monument |
| | 1989 | L.C.R.C. #5176 | John Bueche | K.C. Monument |
| | 1997 | L.C.R.C. #9637 | Kirk Breitels | K.C. Monument |

This corner was originally approved by the Kent County Remonumentation Peer Group and monumented by Williams & Works on 1/30/84 and was recorded per L.C.R.C. #3729.

B. Description of corner evidence found and/or method applied in restoring or reestablishing corner:

C-2 The K.C. Monument set in L.C.R.C. #3729 has been removed. Per the adjacent land owner, the monument was "pulled" and replaced with a 4" x 4" treated wood fence post in concrete. Set P.K. nail in top of fence post using the witnesses found in L.C.R.C. #9637.

L.C.R.C. #9637

- Nail & KC Remon. tag E. face Tri. 18" Oak North 56.62'
- Nail & KC Remon. tag E. face Tw. 12" Maple N 50° E 83.65'
- Nail & KC Remon. tag NE face 14" Oak S 32° E 64.14'
- Nail & KC Remon. tag NW face 10" Oak S 30° W 22.24'
- Nail & KC Remon. tag N. face 24" Oak S 80° W 39.07'

P.A. 345 1990 KENT COUNTY
PEER APPROVED 10/28/99
CHAIRMAN *[Signature]*

The selected location is accepted by me and is generally accepted by professional surveyors as the best available evidence of the position of the original corner.

C. Description of monument for corner and accessories established to perpetuate locating the position of the corner:

C-2 Set P.K. Nail In Top of a 4" x 4" Fence Post

- Nail & K.C. remon. tag on E face Tri. 18" Oak North 56.62'
- Nail & K.C. remon. tag on E face Tw. 12" Maple N 50° E 83.65'
- Nail & K.C. remon. tag on NE face 14" Oak S 32° E 64.14'
- Nail & K.C. remon. tag on NW face 10" Oak S 30° W 22.24'
- Nail & K.C. remon. tag on N face 24" Oak S 80° W 39.07'
- On fence line running N & W



Signed by *[Signature]* Date 12-28-99
WILLIAMS & WORKS
Surveyor's Michigan License No. 25854