

**SURVEY &
REMONUMENTATION**

MAY 22 2000

LAND CORNER RECORDATION CERTIFICATE
Filing Requirement of Act 74, Mich. P.A. 1970
KENT COUNTY REMONUMENTATION

For corners in

SECTION

Kent (County)	Located in: Oakfield Township	Corner Code #
1. Public Land Survey	T <u>9N</u> R <u>9W</u>	<u>C-3</u>
	T _____ R _____	_____
	T _____ R _____	_____
	T _____ R _____	_____
2. Property Controlling in Section	S _____ T _____ R _____	_____
	S _____ T _____ R _____	_____
3. Miscellaneous Property in Sec.	S _____ T _____ R _____	_____
	S _____ T _____ R _____	_____

STATE OF MICHIGAN
COUNTY OF KENT
RECEIVED FOR RECORD
1999 OCT 27 AM 8:35

REG. OF DEEDS

11407
Register of Deeds Stamp & File Number


4. Lot No. _____, Recorded Plat _____
5. Private Claims _____

I, Randy Kolehouse, in a field survey on March 22 19 99, do hereby certify that under requirements of P.A. 74 Michigan P.A. of 1970, the corner points mentioned in lines 1 and 2 above were in conformance with regulations and rules therefore as required in the current manual of survey instructions of the United States Department of the interior, Bureau of Land Management or by a decree of a Court of Law and/or that the corner points mentioned in lines 3, 4 and 5 above were in conformance with the rules of the Michigan Board of Land Surveyors or by a Decree of a Court of Law; established, re-established, monumented, re-monumented, recovered, found as expressed below:

NOTE: Not more than 4 corners, all in the same town and range, may be recorded on this certificate.

A. Description of original monument and accessories and/or subsequent restoration:

C-3	1837	G.L.O. Notes	Cathcart	Set Post
	1935-59	Witness Map	K.C. Surveyor	Stake & Stone
	1981	L.C.R.C. #2078	Nederveld & Jonker	Round Iron
	1982	L.C.R.C. #2873	Jonker Land Surveys	Fnd. Round Iron / Set K.C. Monument
	1989	L.C.R.C. #5177	John Bueche	K.C. Monument
	1997	L.C.R.C. #9638	Kirk Breitels	K.C. Monument

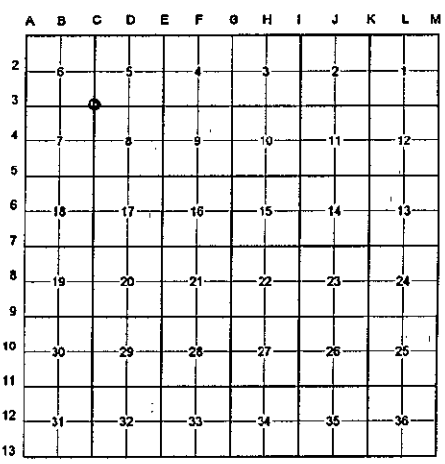

page 345 1990 KENT COUNTY
PEER APPROVED 7/29/99
CHAIRMAN Rob Jonker

This corner was originally approved by the Kent County Remonumentation Peer Group and monumented by Rob Jonker on 5/19/82 and was recorded per L.C.R.C. #2873.

B. Description of corner evidence found and/or method applied in restoring or reestablishing corner:

C-3 Found a Standard Kent County Monument 4' ± North of the C/L intersection of 15 Mile Road (gravel) running East and West and Lappley Avenue (gravel) running South, on line of a fence line running North, per L.C.R.C.'s #2873, #5177 and #9638 as set by Rob Jonker in place of a 3/4"x24" round iron he found which checked L.C.R.C. #2078 and the K.C. Surveyor's records.

L.C.R.C. #2873 L.C.R.C. #9638

Remon. tag on NE side 22" Pine S55°E 74.88'
Remon. tag on N side 36" Pine S65°W 78.02'
Remon. tag on E side 9" Pine S35°W 68.4'
NW corner to conc. fnd. to previously removed brick pillar S45°E 54.35'
SW corner to conc. fnd. to previously removed brick pillar S30°E 59.00'
On line fence to N


Nail & KC Remon. tag NE side 28" Pine S55°E 74.93' (m. 74.90')
Nail & KC Remon. tag N. side 40" Pine S65°W 78.06' (m. 78.02')
Nail & KC Remon. tag E. side 18" Pine S35°W 68.62' (m. 68.65')
Wly corner to conc. fnd. (old pillar) S45°E 53.9' (m. 54.35')
Wly corner to conc. fnd. (old pillar) S30°E 59.0' (m. 59.12')
Face of E. post of sign North 12.57'
C/L "T" of gravel is 4' S.

The selected location is accepted by me and is generally accepted by professional surveyors as the best available evidence of the position of the original corner.

C. Description of monument for corner and accessories established to perpetuate locating the position of the corner:

C-3 Standard Kent County Monument

Nail & K.C. remon. tag on NE side 28" Pine S 55° E 74.90'
Nail & K.C. remon. tag on N side 40" Pine S 65° W 78.02'
Nail & K.C. remon. tag on E side 18" Pine S 35° W 68.65'
Wly cor. to conc. fndn. (old pillar) S 45° E 54.35'
Wly cor. to conc. fndn. (old pillar) S 30° E 59.12'
Face of E post of sign North 12.57'
C/L "X" of gravel roads running E-W & S, South 4' ±
On fence line running N

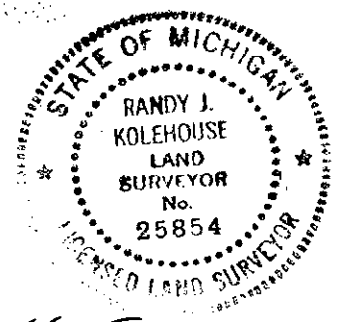

Signed by Randy J. Kolehouse Date 10-11-99
WILLIAMS & WORKS
Surveyor's Michigan License No. 25854