

MAY 28 2000

\$7.00  
\$2.00

SECTION

LAND CORNER RECORDATION CERTIFICATE  
Filing Requirement of Act 74, Mich. P.A. 1970  
KENT COUNTY REMONUMENTATION

For corners in

Kent (County)	Located in: Oakfield Township	Corner Code #
1. Public Land Survey	T 9N R 9W	C-4
	T R	
	T R	
	T R	
2. Property Controlling in Section	S T R	
	S T R	
3. Miscellaneous Property in Sec.	S T R	
	S T R	

REG. OF DEEDS


*[Signature]*

STATE OF MICHIGAN  
COUNTY OF KENT  
RECEIVED FOR RECORD  
1999 DEC - 8 AM 10:06

11542

Register of Deeds Stamp & File Number

- 4. Lot No. \_\_\_\_\_, Recorded Plat \_\_\_\_\_
- 5. Private Claims \_\_\_\_\_

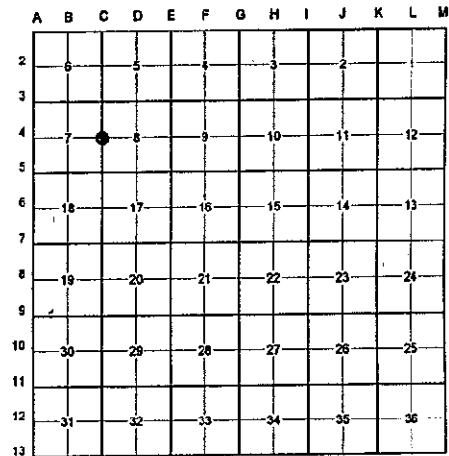

I, Randy Kolehouse, in a field survey on August 31 19 99, do hereby certify that under requirements of P.A. 74 Michigan P.A. of 1970, the corner points mentioned in lines 1 and 2 above were in conformance with regulations and rules therefore as required in the current manual of survey instructions of the United States Department of the Interior, Bureau of Land Management or by a decree of a Court of Law and/or that the corner points mentioned in lines 3, 4 and 5 above were in conformance with the rules of the Michigan Board of Land Surveyors or by a Decree of a Court of Law; established, re-established, monumented, re-monumented, recovered, found as expressed below:

**NOTE: Not more than 4 corners, all in the same town and range, may be recorded on this certificate.**

A. Description of original monument and accessories and/or subsequent restoration:

C-4	1837	G.L.O. Notes	Cathcart	Set Post
	1963	Witness Map	K.C. Surveyor	Monument
	1983	L.C.R.C. #3250	Glen Hackbardt	Conc. Monument
	1984	L.C.R.C. #3730	Williams & Works	Fnd. 1" Iron in Conc. Mon. / K.C. Monument
	1989	L.C.R.C. #5178	John Bueche	K.C. Monument
	1997	L.C.R.C. #9639	Kirk Breitels	K.C. Monument

P.A. 345 1990 KENT COUNTY  
PEER APPROVED 10/28/99  
CHAIRMAN Randy Kolehouse

This corner was originally approved by the Kent County Remonumentation Peer Group and monumented by Williams & Works on 2/2/84 and was recorded per L.C.R.C. #3730.

B. Description of corner evidence found and/or method applied in restoring or reestablishing corner:

C-4 Found a Standard Kent County Monument on the C/L of Lappley Avenue (gravel) running North and South, on line of a tree row running East and West, per L.C.R.C.'s #3730, #5178, and #9639 as set by Williams & Works in place of a 1" iron they found in a concrete monument which checked L.C.R.C. #3250 and the K.C. Surveyor's records.

L.C.R.C. #3730

L.C.R.C. #9639

SE corner Hse N.32°W. 110.6'  
Nail & KC Remon.tag in S'y face 10" Maple N.70°W. 19.85'  
Nail & KC Remon.tag in E'y face 12" Oak S.20°W. 78.05'  
Nail & KC Remon.tag in N'y face 26" Maple N.64°E. 60.03'  
Top C/L M.B.T. terminal box N.45°E. 39.00'  
Nail & KC Remon.tag in W'y face 8" Spruce N.25°E. 110.0'

SE corner house (siding) N32°W 110.6' (m. 110.46')  
Nail & KC Remon. tag S. side 16" Maple N70°W 19.77' (m. 19.77')  
Nail & KC Remon. tag E. side 8" & 18" Oak S20°W 78.15' (m. 78.20')  
Nail & KC Remon. tag N. side 26" Stump N64°E 59.90' (m. 59.99')  
Top C/L MBT terminal box N45°E 38.86' (m. 39.00')  
Nail & KC Remon. tag W. side 16" Spruce N25°E 109.93' (m. 110.01')  
Capped Rerod (Chettleburgh) West 33.02' (m. 33.09')

The selected location is accepted by me and is generally accepted by professional surveyors as the best available evidence of the position of the original corner.

C. Description of monument for corner and accessories established to perpetuate locating the position of the corner:

C-4 Standard Kent County Monument

SE cor. hse. siding N 32° W 110.46'  
Nail & K.C. remon. tag on S side 16" Maple N 70° W 19.77'  
Nail & K.C. remon. tag on E side 8" & 18" Oak S 20° W 78.20'  
Nail & K.C. remon. tag on N side 26" stump N 64° E 59.99'  
Top C/L MBT box N 45° E 39.00'  
Nail & K.C. remon. tag on W side 16" Spruce N 25° E 110.01'

On C/L of gravel road running N-S  
On tree row running E-W  
Capped rerod (Chettleburgh) West 33.09'

Signed by *Randy J. Kolehouse* Date 10/29/99

WILLIAMS & WORKS

Surveyor's Michigan License No. 25854

