

MAY 22 2000

SECTION

LAND CORNER RECORDATION CERTIFICATE  
Filing Requirement of Act 74, Mich. P.A. 1970  
KENT COUNTY REMONUMENTATION

For corners in

Kent (County)	Located in: Oakfield Township	Corner Code #
1. Public Land Survey	T <u>9N</u> R <u>9W</u>	<u>C-5</u>
	T _____ R _____	_____
	T _____ R _____	_____
	T _____ R _____	_____
2. Property Controlling in Section	S _____ T _____ R _____	_____
	S _____ T _____ R _____	_____
3. Miscellaneous Property in Sec.	S _____ T _____ R _____	_____
	S _____ T _____ R _____	_____

REG. OF DEEDS


*[Signature]*

STATE OF MICHIGAN  
COUNTY OF KENT  
RECEIVED FOR RECORD  
1999 OCT 27 AM 8:35

11408

Register of Deeds Stamp & File Number

- 4. Lot No. \_\_\_\_\_, Recorded Plat \_\_\_\_\_
- 5. Private Claims \_\_\_\_\_

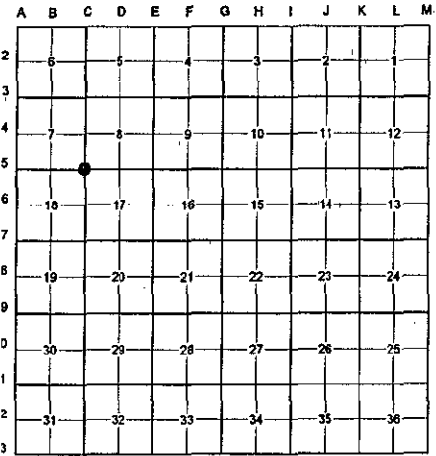

I, Randy Kolehouse, in a field survey on April 26 19 99, do hereby certify that under requirements of P.A. 74 Michigan P.A. of 1970, the corner points mentioned in lines 1 and 2 above were in conformance with regulations and rules therefore as required in the current manual of survey instructions of the United States Department of the Interior, Bureau of Land Management or by a decree of a Court of Law and/or that the corner points mentioned in lines 3, 4 and 5 above were in conformance with the rules of the Michigan Board of Land Surveyors or by a Decree of a Court of Law; established, re-established, monumented, re-monumented, recovered, found as expressed below:

**NOTE:** Not more than 4 corners, all in the same town and range, may be recorded on this certificate.

A. Description of original monument and accessories and/or subsequent restoration:

C-5	1837	G.L.O. Notes	Cathcart	Set Post	P.A. 345 1990 KENT COUNTY
	1932-63	Witness Map	K.C. Surveyor	1" Iron	PEER APPROVED <u>7/29/99</u>
	1983	L.C.R.C. #3250	Glen Hackbardt	Monument Box	CHAIRMAN <u>[Signature]</u>
	1983	L.C.R.C. #3331	Glaza & Associates	N/A	
	1984	L.C.R.C. #3731	Williams & Works	Fnd 1/2" Iron in Mon. Box / Set K.C. Monument	
	1989	L.C.R.C. #5179	John C. Bueche	K.C. Monument in Monument Box	
	1997	L.C.R.C. #9640	Kirk Breitels	K.C. Monument in Monument Box	

This corner was originally approved by the Kent County Remonumentation Peer Group and monumented by Williams & Works on 2/1/84 and was recorded per L.C.R.C. #3731.

B. Description of corner evidence found and/or method applied in restoring or reestablishing corner:

C-5 Found a Standard Kent County Monument 9' ± North of the C/L intersection of 14 Mile Road (bit.) running East and West and Lappley Avenue (gravel) running North per L.C.R.C.'s #3731, #5179 and #9640 as set by Williams & Works in place of a 1/2" iron they found in a monument box which checked L.C.R.C. #3331, L.C.R.C. #3250 and the K.C. Surveyor's records.

L.C.R.C. #3731

L.C.R.C. #9640

C/L pav't 14 Mile Rd. (M-57) running E & W  
- South 9.50' on C/L gravel running North  
Top C/L cor. cemetery fence post N.40°E. 60.64'  
Nail & KC Remon.tag in SE'ly face 15" Hickory N.60°E. 64.70'  
Nail & KC Remon.tag in SW'ly face P.Pole S.50°E. 131.63'  
Nail & KC Remon.tag in NW face P.Pole S.60°W. 120.00'  
NW corner frame school South 100.90'


Top C/L cemetery fence post N40°E 60.52' (m. 60.45')  
Nail & KC Remon. tag S. face 40" Maple N70°E 73.22' (m. 73.20')  
Nail & KC Remon. tag SW face P. Pole S50°E 131.59' (m. 131.55')  
Nail & KC Remon. tag NW face P. Pole S60°W 120.00' (m. 119.95')  
NW corner frame school South 100.90' (m. 100.88')  
Nail & KC Remon. tag S. face P. Pole N 60°W 151.43' (m. 151.41')  
C/L 14 Mile Rd. E-W is south 9.5'+/-

The selected location is accepted by me and is generally accepted by professional surveyors as the best available evidence of the position of the original corner.

C. Description of monument for corner and accessories established to perpetuate locating the position of the corner:

C-5 Standard Kent County Monument

Top C/L cemetery fence post N 40° E 60.45'  
Nail & K.C. remon. tag on S face 40" Maple N 70° E 73.20'  
Nail & K.C. remon. tag on SW side P. pole S 50° E 131.55'  
Nail & K.C. remon. tag on SW side P. pole S 60° W 119.95'  
NW cor. frame school South 100.88'  
Nail & K.C. remon. tag on S side P. pole N 60° W 151.41'  
C/L "X" of bit. road running E-W and gravel road running N, South 9' ±

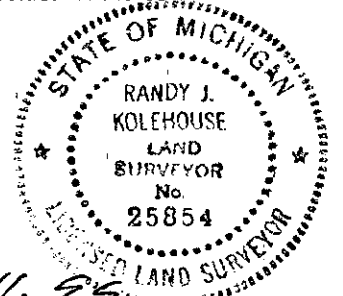

Signed by *[Signature]* Date 10-11-99

WILLIAMS & WORKS

Surveyor's Michigan License No. 25854