

SURVEY & REMONUMENTATION

MAY 22 2000

SECTION

LAND CORNER RECORDATION CERTIFICATE
 Filing Requirement of Act 74, Mich. P.A. 1970
 KENT COUNTY REMONUMENTATION

For corners in

Kent (County)	Located in: Oakfield Township	Corner Code #
1. Public Land Survey	T <u>9N</u> R <u>9W</u>	<u>C-6</u>
	T _____ R _____	_____
	T _____ R _____	_____
	T _____ R _____	_____
2. Property Controlling in Section	S _____ T _____ R _____	_____
	S _____ T _____ R _____	_____
3. Miscellaneous Property in Sec.	S _____ T _____ R _____	_____
	S _____ T _____ R _____	_____

REG. OF DEEDS

[Signature]

STATE OF MICHIGAN
 COUNTY OF KENT
 RECEIVED FOR RECORD
 1999 OCT 27 AM 8:35

11409

Register of Deeds Stamp & File Number

4. Lot No. _____, Recorded Plat _____
 5. Private Claims _____

I, Randy Kolehouse, in a field survey on March 17 19 99, do hereby certify that under requirements of P.A. 74 Michigan P.A. of 1970, the corner points mentioned in lines 1 and 2 above were in conformance with regulations and rules therefore as required in the current manual of survey instructions of the United States Department of the interior, Bureau of Land Management or by a decree of a Court of Law and/or that the corner points mentioned in lines 3, 4 and 5 above were in conformance with the rules of the Michigan Board of Land Surveyors or by a Decree of a Court of Law; established, re-established, monumented, re-monumented, recovered, found as expressed below:

NOTE: Not more than 4 corners, all in the same town and range, may be recorded on this certificate.

A. Description of original monument and accessories and/or subsequent restoration:

C-6	1837	G.L.O. Notes	Cathcart	Set Post
	1956	Witness Map	K.C. Surveyor	1" Iron
	1971	L.C.R.C. #77	M.M. Chambers	1" Iron
	1980	L.C.R.C. #1468	Williams & Works	Fnd. 1" Iron Pipe / Set K.C. Monument
	1989	L.C.R.C. #5180	John Bueche	K.C. Monument
	1997	L.C.R.C. #9641	Kirk Breitels	K.C. Monument

P.A. 345 1990 KENT COUNTY
 PEER APPROVED 7/29/99
 CHAIRMAN [Signature]

This corner was originally approved by the Kent County Remonumentation Peer Group and monumented by Williams & Works on 10/30/80 and was recorded per L.C.R.C. #1468.

B. Description of corner evidence found and/or method applied in restoring or reestablishing corner:

C-6 Found a Standard Kent County Monument 81' ± North of the C/L of Angle Lake Road (gravel) running East and West and 8' ± West of Hse. #10411 per L.C.R.C.'s #1468, #5180 and #9641 as set by Williams & Works in place of a 1" iron pipe they found which checked L.C.R.C. #77 and the K.C. Surveyor's records.

L.C.R.C. #1468

L.C.R.C. #9641

K.C. Remon. Tag & Nail SW Side 20" Maple N 43°W 38.75'
 "T" Iron C/L Angle Lake Road S 05°E 81.15'
 NW Cor. Fnd. Hse. #10411 N 20°E 15.01'
 SW Cor. Fnd. Hse. #10411 S 40°E 21.30'


Nail & KC Remon. tag SW side 30" maple N43°W 38.80' (m. 38.70')
 "T" Iron C/L Angle Lake Road S05°E 81.15' (m. 81.08')
 NW corner hse. #10411 (siding) N20°E 15.1' (m. 15.12')
 SW corner fnd. Hse. #10411 S40°E 21.30' (m. 21.29')

The selected location is accepted by me and is generally accepted by professional surveyors as the best available evidence of the position of the original corner.

C. Description of monument for corner and accessories established to perpetuate locating the position of the corner:

C-6 Standard Kent County Monument

Nail & K.C. remon. tag on SW side 30" Maple N 43° W 38.70'
 "T" iron C/L Angle Lake Rd. S 05° E 81.08'
 NW cor. hse. #10411 (siding) N 20° E 15.12'
 SW cor. fndn. hse. #10411 S 40° E 21.29'
 Nail & K.C. remon. tag on E side P. pole S 20° W 118.02'
 Nail & K.C. remon. tag on S side 12" Cherry S 80° W 145.27'
 C/L of gravel road running E-W, South 81'

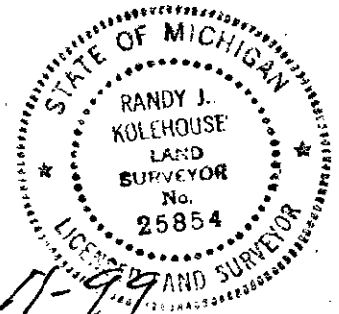

Signed by Randy J. Kolehouse
 WILLIAMS & WORKS

Date 10-11-99

Surveyor's Michigan License No. 25854