

MAY 22 2000

\$7.00
\$2.00

SECTION LAND CORNER RECORDATION CERTIFICATE
Filing Requirement of Act 74, Mich. P.A. 1970
KENT COUNTY REMONUMENTATION


For corners in

Kent (County)	Located in: Oakfield Township	Corner Code #
1. Public Land Survey	T <u>9N</u> R <u>9W</u>	<u>C-7</u>
	T _____ R _____	_____
	T _____ R _____	_____
	T _____ R _____	_____
2. Property Controlling in Section	S _____ T _____ R _____	_____
	S _____ T _____ R _____	_____
3. Miscellaneous Property in Sec.	S _____ T _____ R _____	_____
	S _____ T _____ R _____	_____

STATE OF MICHIGAN
 COUNTY OF KENT
 RECEIVED FOR RECORD
 1999 OCT 27 AM 8:35
 REG. OF DEEDS
 11410
 Register of Deeds Stamp & File Number

4. Lot No. _____, Recorded Plat _____
 5. Private Claims _____

I, Randy Kolehouse, in a field survey on March 17 19 99, do hereby certify that under requirements of P.A. 74 Michigan P.A. of 1970, the corner points mentioned in lines 1 and 2 above were in conformance with regulations and rules therefore as required in the current manual of survey instructions of the United States Department of the Interior, Bureau of Land Management or by a decree of a Court of Law and/or that the corner points mentioned in lines 3, 4 and 5 above were in conformance with the rules of the Michigan Board of Land Surveyors or by a Decree of a Court of Law; established, re-established, monumented, re-monumented, recovered, found as expressed below:

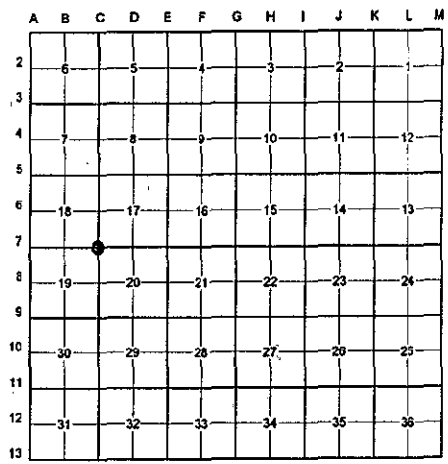

NOTE: Not more than 4 corners, all in the same town and range, may be recorded on this certificate.

A. Description of original monument and accessories and/or subsequent restoration:

C-7	1837	G.L.O. Notes	Calhcart	Set Post
	1981	L.C.R.C. #2047	C.S. Hay	Fnd Conc. Monument / Set K.C. Monument
	1989	L.C.R.C. #5181	John Bueche	K.C. Monument
	1997	L.C.R.C. #9642	Kirk Breitels	K.C. Monument

This corner was originally approved by the Kent County Remonumentation Peer Group and monumented by Clayton Hay on 8/26/81 and was recorded per L.C.R.C. #2047.

B. Description of corner evidence found and/or method applied in restoring or reestablishing corner:

C-7 Found a Standard Kent County Monument 200' ± East of Poplar Drive running North and South, on line of a fence line running East and West, and 55' East of the West edge of swamp per L.C.R.C.'s #2047, #5181 and #9642 as set by Clayton Hay in place of a concrete monument he found that checked Poplar Point Plat L. 35 of Plats, P. 38.

L.C.R.C. #2047

L.C.R.C. #9642

Iron North 50.0 feet (NE corner of Lot 108 Poplar Point Plat)
 Concrete Monument N 89° 26' W (from plat) 47.60'
 North edge of flat flange of steel fence post West 4.53'
 (cor. of fence N. & E.)
 Nail and Tag in North side of 24" Oak S 85 W 63.11'
 Nail and Tag in NE side of 18" Ash N 65° W 62.02'

Iron North 50.0' (NE corner Lot 108 Poplar Point Plat) (m. 50.02')
 Concrete Monument N89°26'W (from plat) 47.60' (m. 47.52')
 North edge of flat flange of steel fc. Post West 4.53' (m. 4.63')
 Nail & KC Remon. tag N. side 30" Oak S85°W 63.11' (m. 63.04')
 Nail & KC Remon. tag NE side 26" Ash N65°W 62.02' (m. 61.96')
 Mon. is in swamp 55' East of bottom bank
 Mon. is ENE of garage #10426 by 150'+/-

The selected location is accepted by me and is generally accepted by professional surveyors as the best available evidence of the position of the original corner.

C. Description of monument for corner and accessories established to perpetuate locating the position of the corner:

C-7 Standard Kent County Monument

Iron (NE cor. Lot 108 Poplar Point Plat) North 50.02'
 Conc. mon. N 89° W 47.52'
 N edge flat flange of steel fence post West 4.63'
 Nail & K.C. remon. tag on N side 30" Oak S 85° W 63.04'
 Nail & K.C. remon. tag on NE side 26" Ash N 65° W 61.96'
 Road running N-S, West 200'
 On fence line running E-W
 West edge of swamp, West 55'

P.A. 345 1990 KENT COUNTY

PEER APPROVED 7/29/99

CHAIRMAN Randy Kolehouse



Signed by Randy Kolehouse

Date 10-11-99

WILLIAMS & WORKS

Surveyor's Michigan License No. 25854