

SURVEY &  
REMONUMENTATION

MAY 22 2000

LAND CORNER RECORDATION CERTIFICATE  
Filing Requirement of Act 74, Mich. P.A. 1970  
KENT COUNTY REMONUMENTATION

For corners in

SECTION

Kent (County)	Located in: Oakfield Township	Corner Code #
1. Public Land Survey	T <u>9N</u> R <u>9W</u>	<u>C-8</u>
	T _____ R _____	_____
	T _____ R _____	_____
	T _____ R _____	_____
2. Property Controlling in Section	S _____ T _____ R _____	_____
	S _____ T _____ R _____	_____
3. Miscellaneous Property in Sec.	S _____ T _____ R _____	_____
	S _____ T _____ R _____	_____
4. Lot No. _____, Recorded Plat _____		
5. Private Claims _____		

REG. OF DEEDS

*[Signature]*

STATE OF MICHIGAN  
COUNTY OF KENT  
RECEIVED FOR RECORD  
1999 OCT 27 AM 8:35

11411

Register of Deeds Stamp & File Number

I, Randy Kolehouse, in a field survey on March 15 1999, do hereby certify that under requirements of P.A. 74 Michigan P.A. of 1970, the corner points mentioned in lines 1 and 2 above were in conformance with regulations and rules therefore as required in the current manual of survey instructions of the United States Department of the Interior, Bureau of Land Management or by a decree of a Court of Law and/or that the corner points mentioned in lines 3, 4 and 5 above were in conformance with the rules of the Michigan Board of Land Surveyors or by a Decree of a Court of Law; established, re-established, monumented, re-monumented, recovered, found as expressed below:

NOTE: Not more than 4 corners, all in the same town and range, may be recorded on this certificate.

A. Description of original monument and accessories and/or subsequent restoration:

C-8	1837	G.L.O. Notes	Cathcart	Set Post
	1935	Witness Map	K.C. Surveyor	Wagon Axle
	1983	L.C.R.C. #3592	William Byl	Fnd Axle / Set K.C. Monument
	1989	L.C.R.C. #5182	John Bueche	K.C. Monument
	1997	L.C.R.C. #9643	Kirk Breitels	K.C. Monument

P.A. 345 1990 KENT COUNTY

PEER APPROVED 7/29/99

CHAIRMAN *[Signature]*

	A	B	C	D	E	F	G	H	I	J	K	L	M
2	6	5	4	3	2								
3													
4	7	8	9	10	11	12							
5													
6	18	17	16	15	14	13							
7													
8	19	20	21	22	23	24							
9													
10	30	29	28	27	26	25							
11													
12	31	32	33	34	35	36							
13													

This corner was originally approved by the Kent County Remonumentation Peer Group and monumented by William R. Byl on 8/29/83 and was recorded per L.C.R.C. #3592.

B. Description of corner evidence found and/or method applied in restoring or reestablishing corner:

C-8 Found a Standard Kent County Monument on the C/L of Nugent Avenue (gravel) running North and South, on line of a fence line and tree row running West, per L.C.R.C.'s #3592, #5182, and #9643 as set by William Byl in place of an axle he found which checked the K.C. Surveyor's records.

L.C.R.C. #3592

L.C.R.C. #9643

Nail & tag, S sd. 12" triple Cherry N 80 E 25.12'  
Nail & tag, E sd. 8" Cherry S 25 E 67.18'  
Nail & tag, W sd. 12" Cherry N 15 E 98.44'  
C/L 1" iron pipe at fence corner N 90 W 33.13'


Nail & KC Remon. tag S. side 14" Tri. Cherry N80°E 25.21' (m. 25.17)  
Nail & KC Remon. tag E. side 18" Cherry S25°E 67.16' (m. 67.12')  
Nail & KC Remon. tag W. side 20" Cherry N15°E 98.45' (m. 98.40')  
Nail & KC Remon. tag E. side 12" Pine N15°W 102.12' (m. 102.04')  
C/L 1" Iron pipe at fence corner N90°W 33.10' (m. 33.08')

The selected location is accepted by me and is generally accepted by professional surveyors as the best available evidence of the position of the original corner.

C. Description of monument for corner and accessories established to perpetuate locating the position of the corner:

C-8 Standard Kent County Monument

Nail & K.C. remon. tag on S side 14" tri. Cherry N 80° E 25.17'  
Nail & K.C. remon. tag on E side 18" Cherry S 25° E 67.12'  
Nail & K.C. remon. tag on W side 20" Cherry N 15° E 98.40'  
Nail & K.C. remon. tag on E side 12" Pine N 15° W 102.04'  
C/L 1" iron pipe @ fence corner N 90° W 33.08'  
On C/L of gravel road running N-S  
On fence line and tree row running W

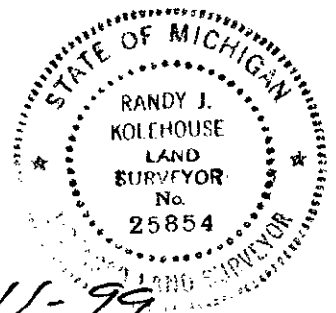

Signed by *Randy J. Kolehouse* Date 10-11-99  
WILLIAMS & WORKS

Surveyor's Michigan License No. 25854