

**SURVEY &
REMONUMENTATION**

\$7.00
\$2.00

MAY 22 2000

LAND CORNER RECORDATION CERTIFICATE
Filing Requirement of Act 74, Mich. P.A. 1970
KENT COUNTY REMONUMENTATION

For corners in

SECTION

<u>Kent</u> (County)	Located in: <u>Oakfield</u> Township	Corner Code # <u>C-9</u>
1. Public Land Survey	T <u>9N</u> R <u>9W</u>	<u>C-9</u>
	T _____ R _____	_____
	T _____ R _____	_____
	T _____ R _____	_____
2. Property Controlling in Section	S _____ T _____ R _____	_____
	S _____ T _____ R _____	_____
3. Miscellaneous Property in Sec.	S _____ T _____ R _____	_____
	S _____ T _____ R _____	_____

REG. OF DEEDS

[Signature]

STATE OF MICHIGAN
COUNTY OF KENT
RECEIVED FOR RECORD
1999 OCT 27 AM 8:35

11412

Register of Deeds Stamp & File Number


4. Lot No. _____, Recorded Plat _____
5. Private Claims _____

I, Randy Kolehose, in a field survey on March 16 19 99, do hereby certify that under requirements of P.A. 74 Michigan P.A. of 1970, the corner points mentioned in lines 1 and 2 above were in conformance with regulations and rules therefore as required in the current manual of survey instructions of the United States Department of the Interior, Bureau of Land Management or by a decree of a Court of Law and/or that the corner points mentioned in lines 3, 4 and 5 above were in conformance with the rules of the Michigan Board of Land Surveyors or by a Decree of a Court of Law, established, re-established, monumented, re-monumented, recovered, found as expressed below:

NOTE: Not more than 4 corners, all in the same town and range, may be recorded on this certificate.

A. Description of original monument and accessories and/or subsequent restoration:

C-9	1837	G.L.O. Notes	Cathcart	Set Post
	1969	Witness Map	K.C. Surveyor	Iron
	1981	L.C.R.C. #2076	Nederveld & Jonker	"T" Iron in Mon. Box
	1982	L.C.R.C. #2870	Jonker Land Surveys	Fnd. "T" Iron / Set K.C. Monument in Mon. Box
	1989	L.C.R.C. #5183	John Bueche	K.C. Monument in Mon. Box
	1997	L.C.R.C. #9644	Kirk Breitels	K.C. Monument in Mon. Box

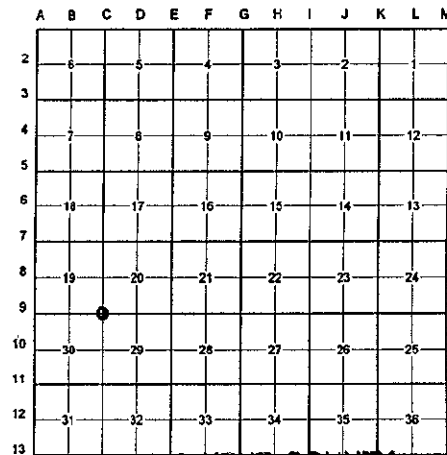

P.A. 345 1990 KENT COUNTY
PEER APPROVED 7/29/99
CHAIRMAN [Signature]

This corner was originally approved by the Kent County Remonumentation Peer Group and monumented by Rob Jonker on 5/24/82 and was recorded per L.C.R.C. #2870.

B. Description of corner evidence found and/or method applied in restoring or reestablishing corner:

C-9 Found a Standard Kent County Monument in a monument box at the C/L intersection of Nugent Avenue (gravel) running North and South and 12 Mile Road (bit.) running East and West per L.C.R.C.'s #2870, #5183 and #9644 as set by Rob Jonker in place of a "T" iron he found in a monument box which checked L.C.R.C. #2076 and the K.C. Surveyor's records.

L.C.R.C. #2870

L.C.R.C. #9644

SW corner hse. fnd. S40°E 125.38' (at top of fnd.)
Remon. tag on SE side 18" W.Cherry N45°E 140.45'
Remon. tag on E side 26" Maple N10°W 110.33'
Remon. tag on SE side p.pole S45°W 100.78'
On C/L "X" intersection

Top of SW corner house foundation S40°E 125.32' (m. 125.40')
Nail & KC Remon. tag SE side 28" Cherry N45°E 139.99' (m. 140.03')
Nail & KC Remon. tag E. side 30" stump N10°W 110.21' (m. 110.14')
Nail & KC Remon. tag NE side 40" Maple N60°W 100.62' (m. 100.64')
Nail & KC Remon. tag SE side P. Pole S45°W 99.07' (m. 99.08')
On C/L "X" intersection

The selected location is accepted by me and is generally accepted by professional surveyors as the best available evidence of the position of the original corner.

C. Description of monument for corner and accessories established to perpetuate locating the position of the corner:

C-9 Standard Kent County Monument in a Mon. Box

Top SW cor. hse. fndn. S 40° E 125.40'
Nail & K.C. remon. tag on E side 28" Cherry N 45° E 140.03'
Nail & K.C. remon. tag on E side 30" stump N 10° W 110.14'
Nail & K.C. remon. tag on NE side 40" Maple N 60° W 100.64'
Nail & K.C. remon. tag on SE side P. pole S 45° W 99.08'
On C/L "X" of bit. road running E-W and gravel road running N-S



Signed by Randy J. Kolehose Date 10-11-99

WILLIAMS & WORKS

Surveyor's Michigan License No. 25854