

MAY 22 2000

SECTION

LAND CORNER RECORDATION CERTIFICATE
Filing Requirement of Act 74, Mich. P.A. 1970
KENT COUNTY REMONUMENTATION

For corners in

Kent (County)	Located in: Oakfield Township	Corner Code #
1. Public Land Survey	T 9N R 9W	C-10
	T _____ R _____	_____
	T _____ R _____	_____
	T _____ R _____	_____
2. Property Controlling in Section	S _____ T _____ R _____	_____
	S _____ T _____ R _____	_____
3. Miscellaneous Property in Sec.	S _____ T _____ R _____	_____
	S _____ T _____ R _____	_____

REG. OF DEEDS

[Signature]

STATE OF MICHIGAN
COUNTY OF KENT
RECEIVED FOR RECORD
1999 OCT 27 AM 8:35

11413

Register of Deeds Stamp & File Number

- 4. Lot No. _____, Recorded Plat _____
- 5. Private Claims _____

I, Randy Kolehouse, in a field survey on March 10 19 99, do hereby certify that under requirements of P.A. 74 Michigan P.A. of 1970, the corner points mentioned in lines 1 and 2 above were in conformance with regulations and rules therefore as required in the current manual of survey instructions of the United States Department of the interior, Bureau of Land Management or by a decree of a Court of Law and/or that the corner points mentioned in lines 3, 4 and 5 above were in conformance with the rules of the Michigan Board of Land Surveyors or by a Decree of a Court of Law; established, re-established, monumented, re-monumented, recovered, found as expressed below:

NOTE: Not more than 4 corners, all in the same town and range, may be recorded on this certificate.

A	B	C	D	E	F	G	H	I	J	K	L	M
2	6	5	4	3	2	1						
3												
4	7	8	9	10	11	12						
5												
6	18	17	16	15	14	13						
7												
8	19	20	21	22	23	24						
9												
10	30	29	28	27	26	25						
11												
12	31	32	33	34	35	36						
13												

A. Description of original monument and accessories and/or subsequent restoration:

C-10 1837	G.L.O. Notes	Cathcart	Set Post
1935	Witness Map	K.C. Surveyor	Conc. Monument
1983	L.C.R.C. #3593	William R. Byl	Fnd. Conc. Monument / Set K.C. Monument
1989	L.C.R.C. #5184	John Bueche	K.C. Monument
1997	L.C.R.C. #9645	Kirk Breitels	K.C. Monument

This corner was originally approved by the Kent County Remonumentation Peer Group and monumented by William Byl on 8/29/83 and was recorded per L.C.R.C. #3593.

B. Description of corner evidence found and/or method applied in restoring or reestablishing corner:

C-10 Found a Standard Kent County Monument at the C/L intersection of Nugent Avenue (gravel) running North and South and Tower Street (gravel) running East, on a tree row running West, per L.C.R.C.'s #3593, #5184 and #9645 as set by William Byl in place of a concrete monument he found which checked the K.C. Surveyor's records.

L.C.R.C. #3593

L.C.R.C. #9645

Nail & tag, N sd. 30" Hickory S 80 E 174.50'
Nail & tag, N sd. 24" Oak S 70 E 87.14'
C/L Street sign post N 55 E 44.0'
C/L South leg, sign post. S 90 W 16.3'

Nail in West end CMP S20°W 78.28' (m. 78.24)
Nail & KC Remon. tag N. side 32" Hickory S80°E 174.50' (m. 174.55)
Nail & KC Remon. tag N. side 30" Oak S70°E 87.15' (m. 87.12)
Top C/L West end CMP N10°W 109.9'
Top C/L East end CMP N10°E 111.5' (m. 111.40)
Centerline South leg, sign post S90°W 16.5'

The selected location is accepted by me and is generally accepted by professional surveyors as the best available evidence of the position of the original corner.

C. Description of monument for corner and accessories established to perpetuate locating the position of the corner:

C-10 Standard Kent County Monument


Nail in W end CMP S 20° W 78.24'
Nail & K.C. remon. tag on N side 32" Hickory S 80° E 174.55'
Nail & K.C. remon. tag on N side 30" Oak S 70° E 87.15'
Top C/L W end CMP N 10° W 109.90'
Top C/L E end CMP N 10° E 111.40'
C/L S leg sign post S 90° W 16.50'
On C/L "X" of gravel roads running North-South and East
On tree row running West

P.A. 345 1990 KENT COUNTY

PEER APPROVED 7/29/99

CHAIRMAN

[Signature]

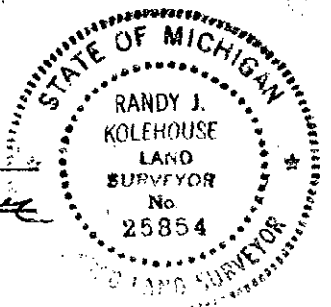

Signed by Randy J. Kolehouse

Date 10-11-99

Surveyor's Michigan License No. 25854