

MAY 22 2000

\$7.00
\$2.00

SECTION

LAND CORNER RECORDATION CERTIFICATE
Filing Requirement of Act 74, Mich. P.A. 1970
KENT COUNTY REMONUMENTATION

For corners in

Kent (County)	Located in: Oakfield Township	Corner Code #
1. Public Land Survey	T <u>9N</u> R <u>9W</u>	<u>C-11</u>
	T _____ R _____	_____
	T _____ R _____	_____
	T _____ R _____	_____
2. Property Controlling in Section	S _____ T _____ R _____	_____
	S _____ T _____ R _____	_____
3. Miscellaneous Property in Sec.	S _____ T _____ R _____	_____
	S _____ T _____ R _____	_____

REG. OF DEEDS

[Signature]

STATE OF MICHIGAN
COUNTY OF KENT
RECEIVED FOR RECORD
1999 OCT 27 AM 8:36

11414

Register of Deeds Stamp & File Number

- 4. Lot No. _____, Recorded Plat _____
- 5. Private Claims _____


I, Randy Kolehouse, in a field survey on March 10 19 99, do hereby certify that under requirements of P.A. 74 Michigan P.A. of 1970, the corner points mentioned in lines 1 and 2 above were in conformance with regulations and rules therefore as required in the current manual of survey instructions of the United States Department of the interior, Bureau of Land Management or by a decree of a Court of Law and/or that the corner points mentioned in lines 3, 4 and 5 above were in conformance with the rules of the Michigan Board of Land Surveyors or by a Decree of a Court of Law; established, re-established, monumented, re-monumented, recovered, found as expressed below:

NOTE: Not more than 4 corners, all in the same town and range, may be recorded on this certificate.

A. Description of original monument and accessories and/or subsequent restoration:

C-11	1837	G.L.O. Notes	Cathcart	Set Post
	1975	L.C.R.C. #810	Exxel Engineering	1" Iron
	1981	L.C.R.C. #1673	Williams & Works	Fnd. 1" Iron / Set K.C. Monument
	1989	L.C.R.C. #5185	John Bueche	K.C. Monument
	1997	L.C.R.C. #9646	Kirk Breitels	K.C. Monument

P.A. 345 1990 KENT COUNTY
PEER APPROVED 7/29/99
CHAIRMAN [Signature]

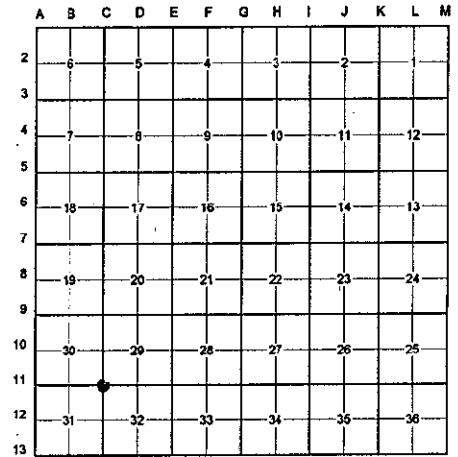

This corner was originally approved by the Kent County Remonumentation Peer Group and monumented by Williams & Works on 4/15/81 and was recorded per L.C.R.C. #1673.

B. Description of corner evidence found and/or method applied in restoring or reestablishing corner:

C-11 Found a Standard Kent County Monument at the C/L intersection of Nugent Avenue (gravel) running North and South and 11 Mile Road (gravel) running East and West per L.C.R.C.'s #1673, #5185 and #9646 as set by Williams & Works in place of a 1" iron they found which checked L.C.R.C. #810.

L.C.R.C. #1673

- K.C. Remon. tag and nail in SE side 40" Oak N.55°E. 39.51'
- K.C. Remon. tag and nail in E side 40" Oak S.40°W. 43.60'
- K.C. Remon. tag and nail in N side Power Tel pole N.75°W. 83.79'
- NE corner metal shed S.65°W. 144.42'

L.C.R.C. #9646


- Nail & KC Remon. tag SE side 50" Oak N55°E 39.58' (m. 39.55')
- Nail & KC Remon. tag E. side 48" Oak S40°W 43.62'
- Nail & KC Remon. tag N. side Power-Tel. Pole N75°W 83.81' (m. 84.25')
- NE corner metal shed S65°W 144.36' (m. 144.35')
- Nail & KC Remon. tag E. side Tw. 15" Cherry N15°W 91.74' (m. 91.70')

The selected location is accepted by me and is generally accepted by professional surveyors as the best available evidence of the position of the original corner.

C. Description of monument for corner and accessories established to perpetuate locating the position of the corner:

C-11 Standard Kent County Monument

- Nail & K.C. remon. tag on SE side 50" Oak N 55° E 39.55'
- Nail & K.C. remon. tag on E side 48" Oak S 40° W 43.62'
- Nail & K.C. remon. tag on N side P./T. pole N 75° W 84.25'
- Nail & K.C. remon. tag on E side twin 15" Cherry N 15° W 91.70'
- NE cor. metal shed S 65° W 144.35'
- On C/L "X" of gravel roads running E-W & N-S

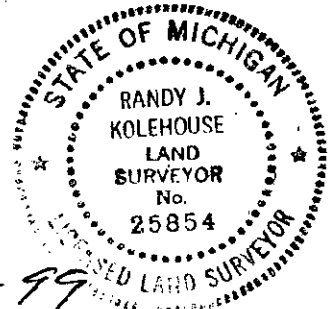

Signed by [Signature] Date 10-11-99

WILLIAMS & WORKS

Surveyor's Michigan License No. 25854