

\$7.00
\$2.00

MAY 22 2000

SECTION

LAND CORNER RECORDATION CERTIFICATE
Filing Requirement of Act 74, Mich. P.A. 1970
KENT COUNTY REMONUMENTATION

For corners in

Kent (County)	Located in: Oakfield Township	Corner Code #
1. Public Land Survey	T <u>9N</u> R <u>9W</u>	<u>D-1</u>
	T _____ R _____	_____
	T _____ R _____	_____
	T _____ R _____	_____
2. Property Controlling in Section	S _____ T _____ R _____	_____
	S _____ T _____ R _____	_____
3. Miscellaneous Property in Sec.	S _____ T _____ R _____	_____
	S _____ T _____ R _____	_____

STATE OF MICHIGAN
COUNTY OF KENT
RECEIVED FOR RECORD
1999 DEC - 8 AM 10:06
REG. OF DEEDS

11543

Register of Deeds Stamp & File Number

4. Lot No. _____, Recorded Plat _____
5. Private Claims _____

I, Randy Kolehouse, in a field survey on August 12 19 99, do hereby certify that under requirements of P.A. 74 Michigan P.A. of 1970, the corner points mentioned in lines 1 and 2 above were in conformance with regulations and rules therefore as required in the current manual of survey instructions of the United States Department of the interior, Bureau of Land Management or by a decree of a Court of Law and/or that the corner points mentioned in lines 3, 4 and 5 above were in conformance with the rules of the Michigan Board of Land Surveyors or by a Decree of a Court of Law; established, re-established, monumented, re-monumented, recovered, found as expressed below:

NOTE: Not more than 4 corners, all in the same town and range, may be recorded on this certificate.

	A	B	C	D	E	F	G	H	I	J	K	L	M
2													
3													
A. Description of original monument and accessories and/or subsequent restoration:

D-1 This corner was not originally set by the G.L.O.

1967	Survey Notes	Williams & Works	Set Boat Spike on Town Line
1984	L.C.R.C. #4006	John Bueche	Fnd. Iron / Set K.C. Monument
1992	L.C.R.C. #6428	John Bueche	K.C. Monument

P.A. 345 1990 KENT COUNTY

PEER APPROVED 10/28/99
CHAIRMAN Randy Kolehouse

Note: This corner is not common with D-13, T10N, R9W.

This corner was originally approved by the Kent County Remonumentation Peer Group and monumented by John Bueche on 10/12/84 and was recorded per L.C.R.C. #4006.

B. Description of corner evidence found and/or method applied in restoring or reestablishing corner:

D-1 Found a Standard Kent County Monument on the C/L of 16 Mile Road (gravel) running East and West per L.C.R.C.'s #4006 and #6428 as set by John Bueche in place of an iron he found on the South line of Section 32, T10N, R9W, that check with Williams & Works survey records.

L.C.R.C. #4006

L.C.R.C. #6428

K.C. Remon. tag & nail in N. side service pole S 25° E 75.64'
K.C. Remon. tag & nail in E. side 8" Poplar S 40° W 37.94'
K.C. Remon. tag & nail in S. side 8" Poplar S 70° W 66.11'
K.C. Remon. tag & nail in N. side 6" Poplar N 75° E 79.14'
C/L gravel road E-W


K.C. Remon. Tag & Nail N side Service Pole S 25° E 75.64' (m. 75.68')
K.C. Remon. Tag & Nail E side 10" Poplar S 40° W 37.84' (m. 37.74')
K.C. Remon. Tag & Nail S side 10" Poplar S 70° W 66.11' (m. 66.20')
K.C. Remon. Tag & Nail N side 8" Poplar N 75° E 79.14'
On C/L gravel road E-W
58' +/- E of E line hse. #10767
K.C. Mon. (S 1/4 32, 10-9) East 138.79'

The selected location is accepted by me and is generally accepted by professional surveyors as the best available evidence of the position of the original corner.

C. Description of monument for corner and accessories established to perpetuate locating the position of the corner:

D-1 Standard Kent County Monument

* Nail & K.C. remon. tag on N side P. pole S 25° E 75.68'
Nail & K.C. remon. tag on S side 10" Poplar S 70° W 66.20'
Nail & K.C. remon. tag on N side 8" Poplar stump N 75° E 79.14'
Nail & K.C. remon. tag on E side 10" Poplar S 40° W 37.74'
Nail & K.C. remon. tag on W side 12" Oak N 45° E 44.42'
Nail & K.C. remon. tag on W side P. pole N 40° W 45.56'
On C/L of gravel road running E-W
K.C. Mon. D-13, T10N, R9W, East 138.79'

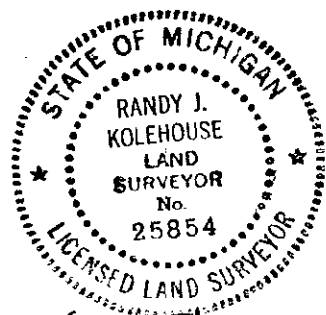

Signed by Randy J. Kolehouse
WILLIAMS & WORKS

Date 10-27-99

Surveyor's Michigan License No. 25854