

\$7.00  
\$2.00

MAY 22 2000

LAND CORNER RECORDATION CERTIFICATE  
Filing Requirement of Act 74, Mich. P.A. 1970  
KENT COUNTY REMONUMENTATION

For corners in

SECTION

Kent (County)	Located in: Township	Oakfield	Corner Code #
1. Public Land Survey	T <u>9N</u>	R <u>9W</u>	<u>D-3</u>
	T _____	R _____	_____
	T _____	R _____	_____
	T _____	R _____	_____
2. Property Controlling in Section	S _____	T _____	R _____
	S _____	T _____	R _____
3. Miscellaneous Property in Sec.	S _____	T _____	R _____
	S _____	T _____	R _____

REG. OF DEEDS


*[Signature]*

STATE OF MICHIGAN  
COUNTY OF KENT  
RECEIVED FOR RECORD  
1999 OCT 27 AM 8:36

11416

Register of Deeds Stamp & File Number

4. Lot No. \_\_\_\_\_, Recorded Plat \_\_\_\_\_  
5. Private Claims \_\_\_\_\_

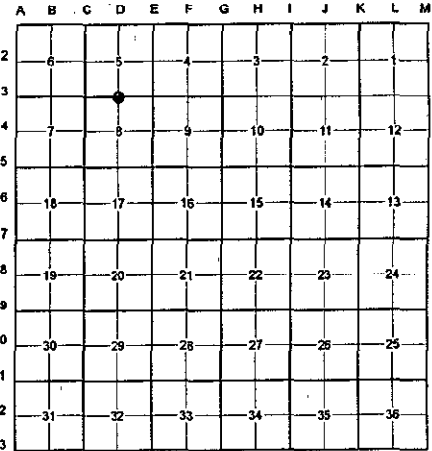

I, Randy Kolehouse, in a field survey on March 22 1999, do hereby certify that under requirements of P.A. 74 Michigan P.A. of 1970, the corner points mentioned in lines 1 and 2 above were in conformance with regulations and rules therefore as required in the current manual of survey instructions of the United States Department of the Interior, Bureau of Land Management or by a decree of a Court of Law and/or that the corner points mentioned in lines 3, 4 and 5 above were in conformance with the rules of the Michigan Board of Land Surveyors or by a Decree of a Court of Law; established, re-established, monumented, re-monumented, recovered, found as expressed below:

NOTE: Not more than 4 corners, all in the same town and range, may be recorded on this certificate.

A. Description of original monument and accessories and/or subsequent restoration:

D-3	1837	G.L.O. Notes	Cathcart	Set Post
	N/A	Witness Map	K.C. Surveyor	Iron
	1986	L.C.R.C. #4501	All Points Surveyors	Rerod
	1991	L.C.R.C. #6582	John Bueche	Fnd. Iron / Set K.C. Monument
	1997	L.C.R.C. #9649	Kirk Breitels	K.C. Monument

P.A. 345 1990 KENT COUNTY  
PEER APPROVED 7/29/99  
CHAIRMAN *[Signature]*

This corner was originally approved by the Kent County Remonumentation Peer Group and monumented by John Bueche in August of 1982 and was recorded per L.C.R.C. #4501.

B. Description of corner evidence found and/or method applied in restoring or reestablishing corner:

D-3 Found a Standard Kent County Monument 3.5' South of the C/L of 15 Mile Road (gravel) running East and West per L.C.R.C.'s #6582 and #9649 as set by John Bueche in place of a rerod he found which checked L.C.R.C. #4501 and the K.C. Surveyor's records.

L.C.R.C. #6582

L.C.R.C. #9649

PK in E side PP S 10° W 58.76'  
Nail in W side 12" Ash North 25.13'  
Nail & K.C. Remon. Tag in N side 30" Oak S 55° W 47.71'  
Nail & K.C. Remon. Tag in NE side 10" Poplar N 45° W 32.04'  
Nail & K.C. Remon. Tag in E side 14" Ash S 50° E 39.12'

PK in E. side PP S10°W 58.81' (m. 58.75')  
Nail W. side 12" Ash North 25.13' (m. 25.17')  
Nail & KC Remon. tag N. side 30" Oak S55°W 47.71' (m. 47.64')  
Nail & KC Remon. tag NE side 12" Poplar N45°W 32.04' (m. 32.03')  
Nail & KC Remon. tag E. side 16" Ash S50°E 39.08' (m. 39.17')  
C/L gravel E-W North 3.5' +/-

The selected location is accepted by me and is generally accepted by professional surveyors as the best available evidence of the position of the original corner.

C. Description of monument for corner and accessories established to perpetuate locating the position of the corner:

D-3 Standard Kent County Monument

Nail & K.C. remon. tag on E side P. pole S 10° W 58.75'  
Nail & K.C. remon. tag on W side 12" Ash North 25.17'  
Nail & K.C. remon. tag on N side 30" Oak S 55° W 47.64'  
Nail & K.C. remon. tag on NE side 12" Poplar N 45° W 32.03'  
Nail & K.C. remon. tag on E side 16" Ash S 50° E 39.17'  
C/L of gravel road running E-W, North 3.5'



Signed by *[Signature]* Date 10-11-99

WILLIAMS & WORKS

Surveyor's Michigan License No. 25854